


Section 35 Township 9 Range 21W

Well No. #3 DeYoung

Company C & G Drig.

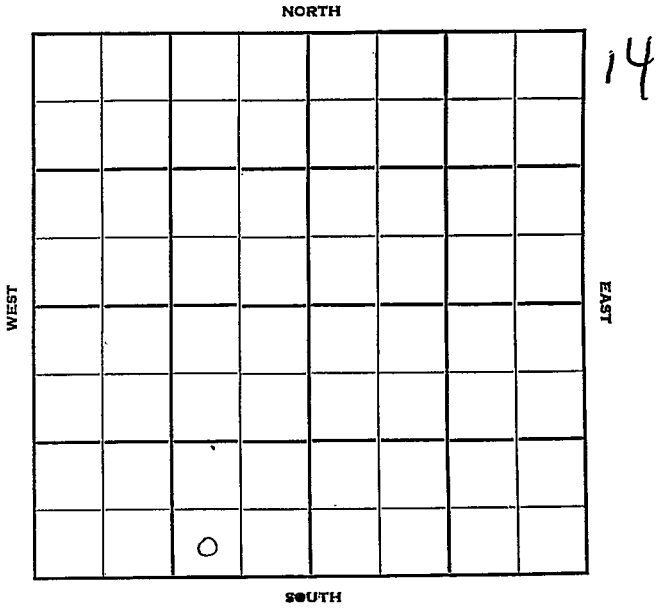

Sec. 35 Twp. 9 R. 21W

Well No. #3 DeYoung Farm

C & G Drlg. Company

Cooper Pool Contractor


Ft. from N. Line

330 Ft. from S. Line

990 Ft. from E. Line

Ft. from W. Line

SW SE SW

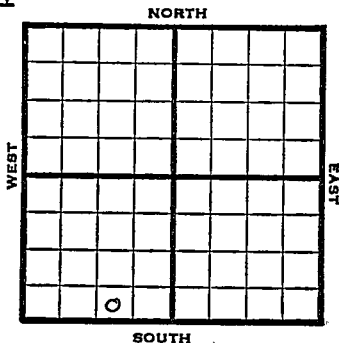

1951 Elev. 2292' REPORT

12/5 Spud 12-1-51
8" @ 156
Anhy 1762
Drlg. 2390

1952
1/30 Spud 12-1-51
Oilwell TD 3858
8" @ 156
Anhy 1762 KC 3537
B KC 3757 Simp. 3827
ReArb. 3829 Arb. 3844-53
5" @ 3849 CO to 3858 FU 1300' oil
1 hr. 2200' oil 4 hr. S/ 7 BOPH
500 A S/ 35 BOPH Comp. 3000 BOPD

COMPLETED

