


Section 35 Township 9 Range 22W

Well No. #1 Collison

Company Don Jones

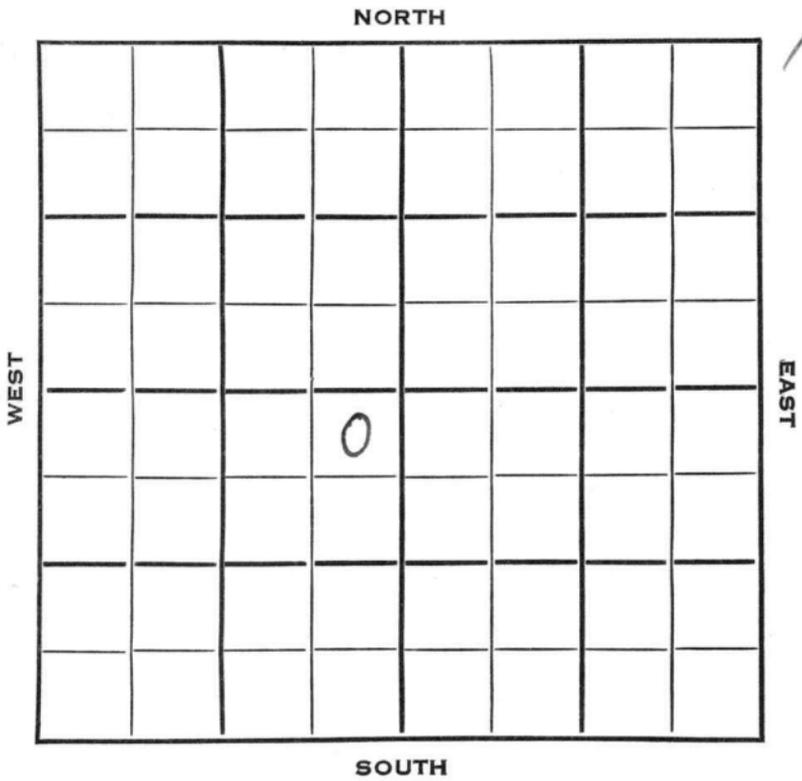

Graham

KANSAS

SEC.	TWP.	R.
35	9	22 W ✓

WELL NO. \_\_\_\_\_

COMPANY # 1 Collison FARM

CONTRACTOR Don Jones


Glenn Peel  
Wildcat

330 \_\_\_\_\_ Ft. from N. Line

\_\_\_\_\_ Ft. from S. Line

330 \_\_\_\_\_ Ft. from E. Line

\_\_\_\_\_ Ft. from W. Line

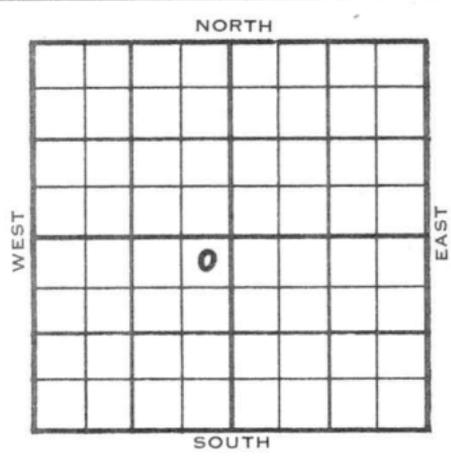

NE NE SW  
Sunray - DHM

	ELEVATION	REPORT
1953	2331'	

9/23 8" @ 192  
Anhy 1820'  
Drlg. 3030'

9/30 D & A TD 3985 8" @ 192  
Anhy 1820 Heeb 3526 Lans 3565  
DST 3592-3611 open 1 hr rec 131'  
wtr. 1100# B KC 3789 Arb. 3969  
TD 3985  
D & A

**ABANDONED**

County Graham State Kansas

Sec. 35 (Blk.) 9 (Sur. Rge.) 22W Map No.

Operator Don Jones

Well No. 1 Farm Collison

Elev. 2331 Location NE NE SW


FIRST REPORT

330 Ft. From N Line SW

330 Ft. From E Line Quarter

Ist. Report SEP 23 1953

Completion \_\_\_\_\_

Remarks Sunray - DHM

Glenn Peel - Contr.

Spudding Date \_\_\_\_\_

Drlg. Data Wildcat

8" @ 192 Anhy 1820 drlg. 3030


County Graham State Kansas

Sec. 35 (Blk. 9) (Sur. 22W) Map No.

Operator Don Jones

Well No. 1 Farm Collison

Elev. 2331 Location NE NE SW

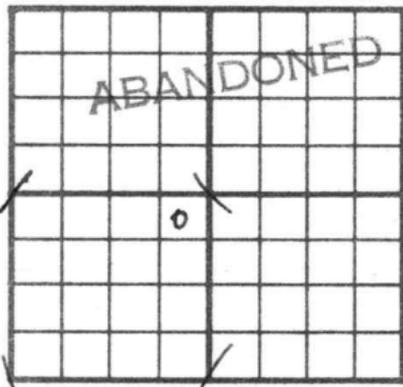

330 Ft. From N Line SW

330 Ft. From E Line Quarter

Ist. Report

Completion SEP 30 1953

Remarks Wildcat

Glenn Peel - Contr.

Spudding Date

Drig. Data D & A TD 3985

8" @ 192 Anhy 1820 Heeb. 3526

Lans. 3565 DST 3592-3611 open 1 hr.

Rec. 131' wtr. 1100# B KC 3789

Arb. 3969 TD 3985

D & A