


SECTION 35 TOWNSHIP 9S RANGE 22W

WELL NO. #2-Collison

COMPANY Oil Property Management, Inc.

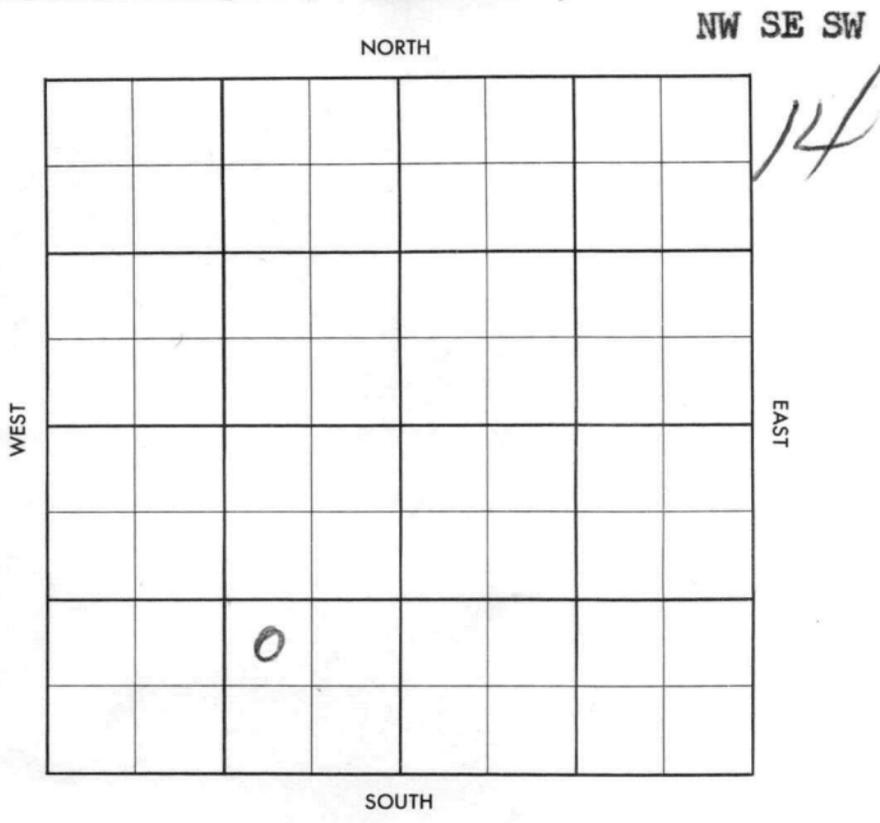

County Graham Elev. 2333 KB  
 Sec. 35 Twp. 9 Rgs. 22W  
 Company Oil Property Management, Inc.  
 Farm Name Collison No. 2

TOPS	DEPTH	LOG	DATUM
Anh.			
Tr.			
H.	<u>3519</u>		
Tr.	<u>3512</u>		
Dg.			
Bl.			
L.	<u>3556</u>		
K.C.			
B.K.C.			
Ce.			
C.			
M.			
M.			
K.			
Mz.			
Mq.			
V.			
S.			
S.			
A.			
R.			
Pe.			
G.			
T.D.			

Loc. in Sec. NW SE SW  
 Geol. \_\_\_\_\_  
 Contr. \_\_\_\_\_  
K & E Drig.  
 Pool RED LINE  
Brassfield

FIRST REPORT  
 JUL 24 57

Date Comm. 8" @ 251 drig. 3565

5

Co.  
 Use.  
 No.  
 Sec.  
 T.  
 R.

2330 DE

County	Graham	Elev.	2333 KB
Sec.	35	Imp.	9
		Rgs.	22W
Company	Oil Property Management, Inc.		
Farm Name	Collison	No.	2

TOPS	DEPTH	LOG	DATUM	Loc. in Sec.
Anh.				NW SE SW
Tp.				
H.	3519			
Tr.	3942			
Dg.				
Bl.				
L.	3556			Geol.
K.C.				Contr.
B.K.C.	3788			K & E Drlg.
Ce.				
C.				Pool
M.				Brassfield
M.				
K.				
Mz.				
Ma.				
V.				
S.				
S.				
A.				
R.				
Pe.				
G.				
T.D.	3820			

AUG 22 '57  
COMPLETE  
0

Date Comm.

8" @ 251 drlg. 3565 JUL 31 '57 DST  
 3558-65 1hr 800' SW BHP 1221  
 120 DST 3583-3623 1hr 340'  
 HOCH + 80' oil BHP 1204/20  
 DST 3626-65 1hr 210' ME'W  
 BHP 1294/20" DST 3684-3713  
 1hr 10' OCH + 130' HOCH + 150'  
 FRO999 oil + 200' cl. oil 461/20"  
 DST 3710-49 1hr 20' Md + 550

PB 3775 16/3744-48 B  
 1 GO 1hr 1/2 \$ 5 BO 1hr  
 \$ AV. 2 1/2 Boph 4 hrs no/w  
 2 \$ AV 4 Boph no/w  
 6 hrs Pop AUG 21 '57 Phy P 210 No X  
 Lev 37° Lon

3697-3

35-9-22

ms se sw

*Red Line*

*4550 DL*

County Graham Elev. 2333 KB  
 Sec. 35 Twp. 9 Rge. 22W  
 Company Oil Property Management, Inc.  
 Farm Name Collison No. 2

Co. *J. J. Papp* Prop. *Manag.* Use.

TOPS	DEPTH	LOG	DATUM
Anh.			
Tp.			
H.	<i>3519</i>		
Tr.	<i>3912</i>		
Dg.			
BL			
L.	<i>3556</i>	<i>1223</i>	
K.C.			
B.K.C.	<i>3788</i>	<i>1455</i>	
Ce.			
C.			
M.			
M.			
K.			
Mz.			
Ma.			
V.			
S.			
S.			
A.			
R.			
PE.			
G.			
T.D.	<i>3820</i>		<i>-1490</i>

Loc. in Sec. NW SE SW  
 Geol. \_\_\_\_\_  
 Contr. K & E Drlg.

Pool Brassfield

<b>CORRECTION</b>		

Collison No. 2 Sec. 35 T. 9 R. 22

Date Comm. 2330  
 8" @ 251 drlg. 3565 *NOV 31 '57 DST*  
 3558-65 lhu 800' SW BHP 1221  
 120 DST 3583-3623 lhu 340'  
 HOCM + 80' oil BHP 1204/120  
 DST 3626-65 lhu 210' MEW  
 BHP 1294/120" DST 3684-3713  
 lhu 10' OCM + 130' HOCM + 150'  
 F10994 oil + 200' cl. oil 461/120"  
 DST 3710-49 lhu 20' Md + 550

*Information*  
 (Correction of 2nd sheet on  
 previous completion ticket  
 on this well)

157/20" 5 1/2 3812 MILT CO AUG 8 '57

CO 24/3697-3703 16/3705-09

50 gal Acid B 5 Goph no/w

3 hrs B \$ AV. 19 Boph no/w

3 hrs AUG 14 '57 AUG 21 '57 AUG 29 '57 w o P o T

Comp. 210 lard nat. 37 gr.

~~P B 3775 16/3744~~

~~-48 B 160 in 1 hr 1/2 \$~~

~~St B 1 hr \$ AV. 2 1/2 Boph~~

~~4 hrs no/w 2 \$ AV. 4~~

~~Boph note 6 hrs P o T~~

SEP 4 '57 SEP 11 '57 SEP 18 '57 SEP 25 '57 OCT 2 '57  
OCT 9 '57

35-9-22w

nw se sw