

KANSAS

Section 35 Township 9 Range 23WWell No. #1 DieboltCompany Harry Gore

NORTH

SOUTH

WEST

EAST

10

0.

Graham

KANSAS

Sec. 35 Twp. 9 R. 23 W ✓

Well No. # 1 Diebolt Farm

Harry Gore Company

Strain Drlg. Contractor

Law Pool

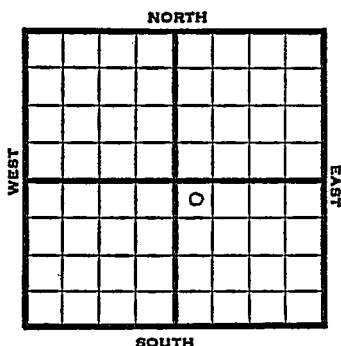
330 Ft. from N. Line

 Ft. from S. Line

 Ft. from E. Line

330 Ft. from W. Line

NW NW SE



1951

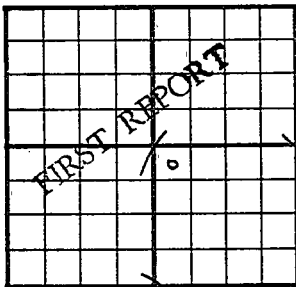
Elev. 2436' REPORT

5/16

Spud 5-10-51
8" @ 199
Anhy 1989-2039'
Drlg. 2765'

5/29

Spud 5-10-51
D&A TD 4204
8" @ 199 Anhy 1989-2039
Heeb. 3710 Br Lime 3734
Lans. 3742 SO 3745-50
DST 3746-56 opn 1 hr Rec. 35' mud
DST 3830-44 opn 1 hr Rec. 86' mud
& wtr Marmaton 4070
Cong. 4159 TD 4204
D&A **ABANDONED**

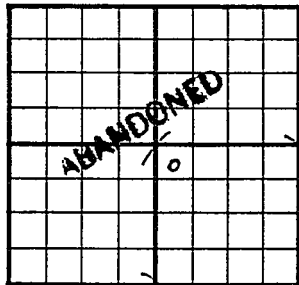
County Graham State KansasSec. 35 (Blk. 9) (Sur. 23W) Map No.Operator Harry GoreWell No. 1 Farm DieboltElev. Location NW NW SE330 Ft. From N Line SE330 Ft. From W Line Quarter1st. Report MAY 16 1951

Completion

Remarks

Strain Drlg. - Contr.Spudding Date 5-10-51Drlg. Data Law Pool8" @ 199 Anhy 1989-2039 drlg. 2765

J. E. TYRA

County Graham State KansasSec. 35 (Blk. 9) (Sur. 23W) Map No. 23WOperator Harry GoreWell No. 1 Farm DieboltElev. 2436 Location NW NW SE330 Ft. From N Line SE330 Ft. From W Line Quarter1st. Report Completion MAY 29 1951Remarks Law PoolStrain Drlg. - Contr.Spudding Date 5-10-51Drlg. Data D & A TD 42048" @ 199 Anhy 1989-2039 Heeb. 3710Br. lime 3734 Lans. 3742 SO 3745-50DST 3746-56 open 1 hr. Rec. 35' mudDST 3830-44 open 1 hr. Rec. 86' mud& water Marmaton 4070 Cong. 4159TD 4204 D & A

J. E. TYRA