


Section 35 Township 9 Range 23W

Well No. 3 Diebolt

Company Amerada

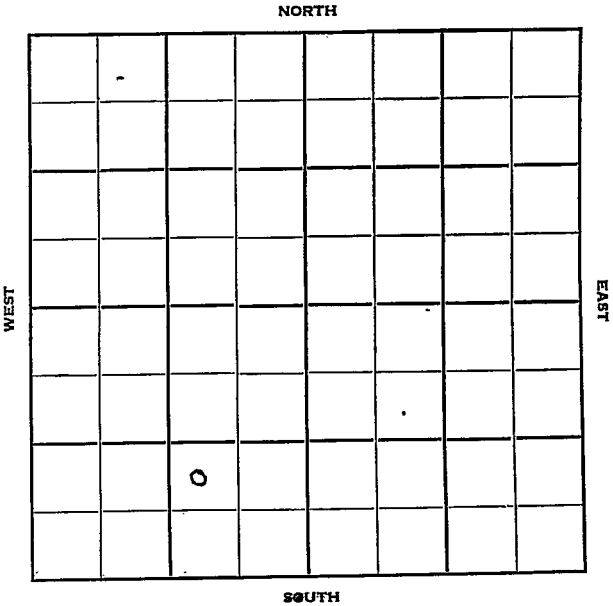

Graham

KANSAS

Sec. 35 Twp. 9 R. 23 W

Well No. # 3 Diebolt Farm

Amerada Company

Law Pool


Ft. from N. Line

990 Ft. from S. Line

990 Ft. from E. Line

Ft. from W. Line

NW SE SW

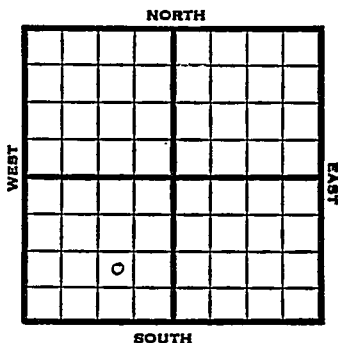

1951 Elev. 2444' REPORT

7/25 Location

10/3 Spud 8-1-51

Oil well TD 3975' 8" @ 214'
Top 3468' Heeb 3688' KC 3725'
DST 3730-65 open 2 hr. rec 213' SOCM
122' HOCM, 2335' free oil, 30' water
DST 3770-3860, open 2 hr. rec 75' SOCM,
1423' HOCM, 122' free oil, 30' O & WCM
DST 3862-3950 open 2 hr. rec 208' O &
GCM,
B KC 3945' TD 3975' 5" @ 3974'
4/3932-42, 19 GWPB 4/3910-22
29 GOPH 4/3892-3905 44 GOPH
4/3878-86 15 GOPH 1500 A
S/61 BO 11 hr. S/32 BO 8 hr.
20/3837-42 40/3827-39 48/3802-14
51 GW 6 hr. PB 3788' 33/3778-86
32/3770-78 1000 A S/253 BO 5½ hr
P/70 BF 4 hr. 9% water
Comp. BHB 1857 BOPD 12% water.

COMPLETED

County **Graham** State **Kansas**

Sec. **35** (Blk. **9** (Sur. **23W** Map No.

Operator Amerada

Well No. **3** Farm **Diebolt**

Elev.	Location	NW	SE	SW
-------	----------	----	----	----

FIRST REPORT

990 Ft. From S Line SW

990 Ft. From F Line Quarter

1st. Report **JUL 25 1951**

Completion

Remarks _____


Spudding Date .

Drig. Data Law Pool

Location _____

J. E. TYRA

County Graham State Kansas
 Sec. 35 (Blk. 9) (Sur. 23W) Map No.
 Operator Amerada
 Well No. 3 Farm Diebolt
 Elev. 2444 Location NW SE SW

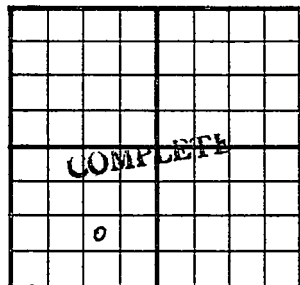

990 Ft. From S Line SW
990 Ft. From E Line Quarter
 Ist. Report
 Completion OCT 3 1951
 Remarks Law Pool

Spudding Date 8-1-51

Drilg. Data Oil well TD 3975

8" @ 214 Top. 3468 Heeb. 3688

KC 3725 DST 3730-65 open 2 hr.

Rec. 213' socm 122' hocm 2335' free oil

30' water DST 3770-3860 open 2 hr.

Rec. 75' socm 1423' hocm 122' free oil

30' o & wcm DST 3862-3950 open 2 hr.

Rec. 208' o & gcm B KC 3945 TD 3975

5" @ 3974 4/ 3932-42 19 gwph

4/ 3910-22 29 goph 4/ 3892-3905

44 goph 4/ 3878-86 15 goph 1500 A

S/ 61 bo 11 hr. S/ 32 bo 8 hr.

20/ 3837-42 40/ 3827-39 48/ 3802-14

51 gw 6 hr. PB 3788 33/ 3778-86

32/ 3770-78 1000 A S/ 253 bo 5½ hr.

J. E. TYRA

Drig. Data

P/ 70 bf 4 hr. 9% water

Comp. BHB 1857 bopd 12% water

Secret Cards
Land Small Map
Land Wall Map
Tracings
Range Map
Place Map
Misc.

lucy

OCT 24 1961