FORM 51 10M 7-48 PETROL


Graham

KANSAS

Section 35 Township 9 Range 23W

Well No. #2 Rice

Company Champlin Refg.

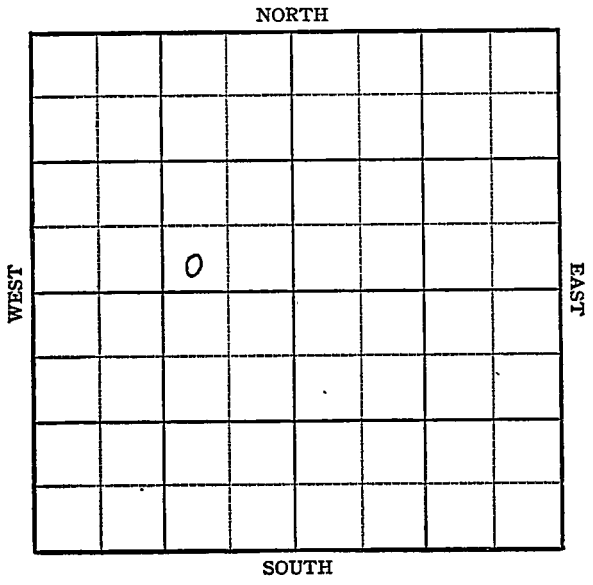

6

FORM 252-B
10M 11-50 PETROL

KANSAS

Sec. 35 Twp. Graham 9 R. 23W

Well No. #2 Rice Farm

Champlin Refg. Company

Contractor

Law Pool


Ft. from N. Line

330' Ft. from S. Line

990' Ft. from E. Line

Ft. from W. Line

SW SE NW

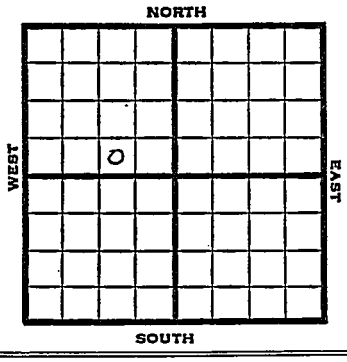

1951	Elev. 2444' REPORT
5/29	Spud 5-27-51 8" @ 190' WOC
6/20	Spud 5-27-51 D&A TD 4265 8" @ 190 Top 3487 Heeb. 3704 KC 3741 DST 3745-56 opn 1 hr Rec. 30' socm Arb. 4254 TD 4265 D&A ABANDONED

FORM 275 FOR SALE BY KANSAS BLUE PRINT CO.


County Graham State Kansas

Sec. 35 (Blk. Twp.) 9 (Sur. Rge.) 23W Map No.

Operator Champlin Ref.

Well No. 2 Farm Rice

Elev. Location SW SE NW

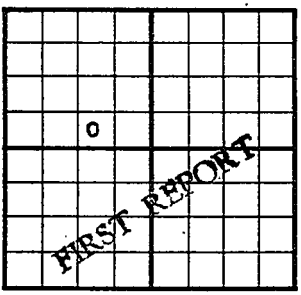

330 Ft. From S Line NW

990 Ft. From E Line Quarter

1st. Report MAY 29 1951

Completion

Remarks

Spudding Date 5-27-51

Drlg. Data Law Pool

8" @ 190 WOC

J. E. TYRA

FORM 275 FOR SALE BY KANSAS BLUE PRINT CO.


County Graham State Kansas

Sec. 35 (Blk. Twp.) 9 (Sur. Rge.) 23W Map No.

Operator Champlin Ref.

Well No. 2 Farm Rice

Elev. 2444 Location SW SE NW

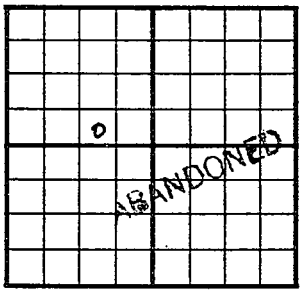

330 Ft. From S Line NW

990 Ft. From E Line Quarter

1st. Report

Completion JUN 20 1951

Remarks Law Pool

Spudding Date 5-27-51

Drlg. Data D & A TD 4265

8" @ 190 Top. 3487 Heeb. 3704

KC 3741 DST 3745-56 open 1 hr.

Rec. 30' socm Arb. 4254 TD 4265

D & A

J. E. TYRA