


Graham

Section 35 Township 9 Range 23WWell No. #4 DieboltCompany Amerada

NORTH

WEST

EAST

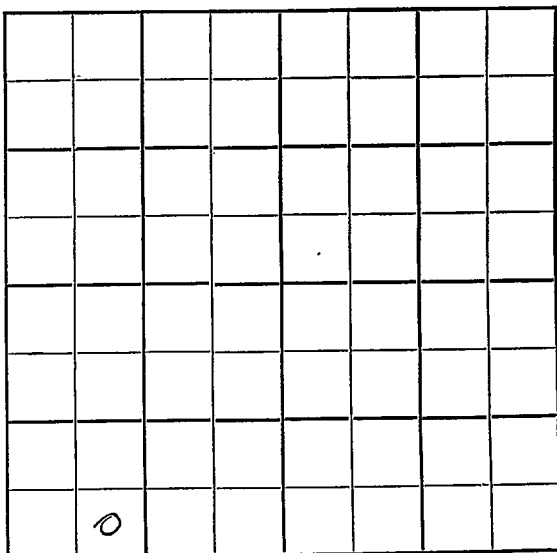

SOUTH

13

Graham

KANSAS

Sec. 35 Twp. -9 R. 23W ✓

Well No. #1 Diebolt Farm

Amerada Company

Peel Drlg. Contractor

Law


 Ft. from N. Line

330 Ft. from S. Line

 Ft. from E. Line

990 Ft. from W. Line

SE SW SW

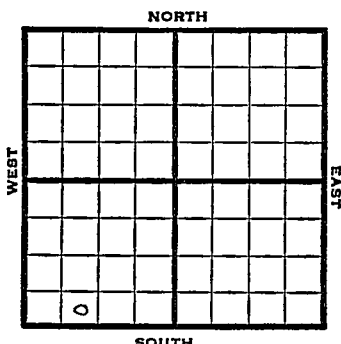

1951

Elev. 2130'

REPORT

10/31

Location

1952

1/9

Spud 11-24-51

Oil well TD 3952' 10" @ 215

Anhy 2000' Heeb 3670' Br. line 3693'

Lans. 3707'

DST 3704-50 open 2 hr. gas in 30 min.

rec 190' HOCM (90% oil) 790' oil

B KC 3930' TD 3952' 7" @ 3751

S/30 BOPH 88/3710-32 S/31 BOPH


1000 A P/18 BOPH

Comp. 1838 BOPD

COMPLETED

J. E. TYRA

County Graham State Kansas
 Sec. 35 (Blk.) 9 (Sur.) 23W Map No.
 Operator Amerada Pet.
 Well No: 4 Farm Diebolt
 Elev. 2430 Location SE SW SW

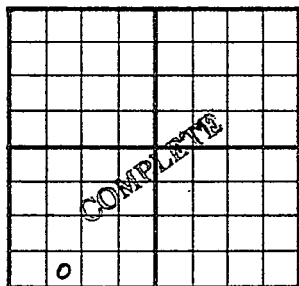

330 Ft. From S Line SW
990 Ft. From W Line Quarter
 1st. Report
 Completion JAN 9 1952
 Remarks Law Pool
Peel Drlg. - Contr.
 Spudding Date 11-24-51

Drlg. Data Oil well TD 3952
10" @ 215 Anhy 2000 Heeb. 3670
Br. lime 3693 Lens. 3707 DST 3704-50
open 2 hr. gas in 30 min. Rec. 190'
hocm (90% oil) 790' oil B KC 3930
TD 3952 7" @ 3751 S/ 30 boph
88/ 3710-32 S/ 31 boph 1000 A
P/ 18' boph Comp. 1838 bopd

J. E. TYRA