

(WH7-DC68) ✓


Graham

KANSAS

SECTION 35 TOWNSHIP 9 RANGE 24W

WELL NO. #1 Gano

COMPANY Murfin-Rains & Williamson

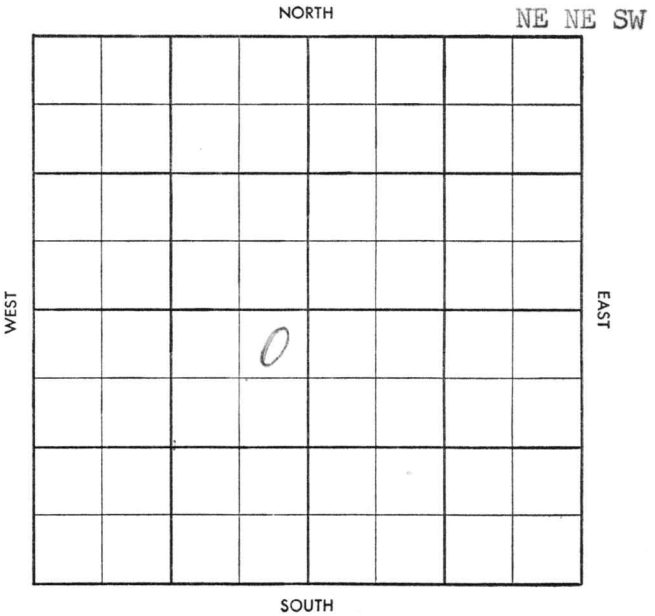


SEC. 35 TWP. 9 S R. 24 W

WELL NO. **Gano**
1 ~~WILLIAMSON~~ FARM

COMPANY **Murfin-Rains & Williamson Oil Co.**
 CONTRACTOR

Murfin-Drlg. Tools
Wildcat

_____ FT. FROM N. LINE
 _____ FT. FROM S. LINE
 _____ FT. FROM E. LINE
 _____ FT. FROM W. LINE

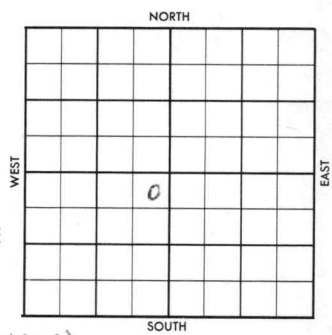

NE NE SW

SDX-DHC-\$2000.00 (Lse S-35626)

1957 ELEVATION 2460' DF REPORT (WH7-DC68) ✓

To drill to a depth sufficient to penetrate 100' into the **Abuckle** formation appx 4600'
 To be commenced by Nov. 10, 1957
 To be completed by Dec. 10, 1957
 (See DHC Agrt 10-11-57)

10/30 Location (FR Tkt)
 11/13 Spud 10-29-57
 8-5/8" @ 213/150
 Hb 3771' Tr 3794' Lsg 3810'
 DST 3830-53, 30", rec 5' M. FP 0#
 BHP 1175# 20"
 DST 3878-3903', 30", rec 5' M.
 FP 0# BHP 1045# 20"
 DST 3934-4000', 30", rec 12' M. FP 0#
 BHP 715# 20". BKC 4034' Ft.Scott
 4158', Cherokee 4212', M. 4339'
 Gilmore City 4413', K 4445', V 4467'
 S. 4513' Arb. 4524'
 TD 4550' Log tops: Hb 3767', Tr. 3791'
 Lsg 3804', BKC 4028', Ft.Scott 4154'
 Miss. 4346', Viola 4465', S 4509'
 Arb. 4519' Log TD 4550'
 D & A (Scout Completion Ticket)

ABANDONED ✓

Section

ELEV. 2460

ABANDONED

SEC. 35 TWP. 9 RGE. 24W

COMPANY Murfin Rains & NO. 1

NOV 13 1957

SDX-DHM

Williamson

FARM Gano

WH7-0668

LOC. NE NE SW

GEOL.

CONTR. Murfin Orig. Tools

POOL Wildcat

SPUD 10-29-57

D6A

Location 8 5/8" 213/150

~~3650~~ Hb 3731 TR 3794

Lsg 3810 Ø 3853

~~3830~~ DST 3830-53 30"

rec 5' M FPO BHP 1175/20" DST

3878 - 3903 30" rec 5' M

FPO BHP 1045/20" DST 3934

- 4000 30" rec 12' M FPO BHP

715/20" BK 4034 Ft Scott 4158

Cherokee 4212 M 4339

Gilmore City 4413 K 4445

U 4467 S 4513 Arb 4524

TD 4550 Log tops

Hb 3767 TR 3791 Lsg 3804 BK 4028

Ft. Scott 4154 Miss 4346

Viola 4465 S 4509 Arb 4519

LTD 4550

D6A

CORNER
LSE.
NO.
SEC.
TWP.
RGE.