

Section 36 Township 9 Range 20 WWell No. # 2 GishCompany Francis Oil & Gas

NORTH

13

SOUTH

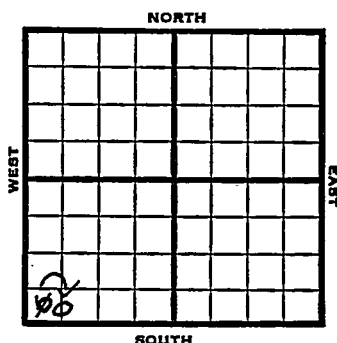
WEST

EAST

Handwritten note in bottom-left cell: 

Rooks

KANSAS ✓

Sec. 36 Twp. 9 R. 20WWell No. #2 Gish FarmFrancis Oil & Gas CompanySpeer Drlg. Contractor Ft. from N. Line330 Ft. from S. Line Ft. from E. Line600
330 Ft. from W. LineC S L SW SW
SW SW SW

1952 Elev. 2249' REPORT

12/3 Spud 12-1-52

12/11 8" @192 Anhy 1686 Ø3075

12/18 Heeb 3447 Lans 3488 DST 3636-51 50 Mins
 230' M 180' SOCM 300' wtr Rew ARB
 3773 Arb 3777 RTD 3782 5" @ 3778

12/25 " " " " " " "

1/1 CO 3782 FU 2600' oil 3 Hrs. S/21 BOPH
 5 Hrs. DD 3785 TD S/38 BOPH 3 Hrs.
 2000' Off BTM

1/8 POP

1/15 "

1/23 Spud 12-1-52

Oil Well

TD 3785

8" @ 192

Anhy 1686k Heeb. 3447, Lans
3488

DST 3636-51, opn 50 mins., rec.
 230' mud, 180' socm, 300' wtr.
 0#

ReArb. 3773, Arb. 3777

TD 3782,

5" @ 3778, CO to 3782, FU 2600'
 oil 3 hrs., S/21 BOPH 5 hrs.

DD 3785, S/38 boph 3 hrs.

Comp 3000 bopd

COMPLETED

County **Rooks** State **Kansas**

Sec. **36** (Blk.) **9** (Sur.) **20W** Map No.

Operator **Francis Oil & Gas**

Well No. **2** Farm **Gish**

Elev.	Location	SW SW SW
-------	----------	----------

0 FIRST REPORT

330 Ft. From S Line SW

330 Ft. From ~~FF~~ Line Quarter

1st. Report DEC 3 1952

Completion

Remarks

Speer Drlg. - Contr.

Spudding Date **12-1-52**

Drlg. Data _____

Kansas

Map No. _____ Sec. 36 Twp. 9 R. 20W

Well No. 2 Gish

Francis Oil & Gas Company

CORRECTION Contractor

C S L SW SW

SECTION PLAT

_____ Ft. from N. Line

330

_____ Ft. from S. Line

_____ Ft. from E. Line

660

_____ Ft. from W. Line

Rooks County

Location _____

Rig up _____

Drilling and Remarks:

Reported
SW SW SW

RECORD

Cased _____ in., _____ ft.

Sand _____

Gas _____

Oil _____

Total Depth _____

PRODUCTION

1st 24 hrs. Nat. _____

1st 24 hrs. after shot _____

Gas _____ Cu. Ft.

Dry Hole _____

Abandoned _____

Date

DEC 3 1952 '19

J. G. McGENEE

Scout

County _____ Rocks _____ State Kansas
 Sec. 36 (Blk.) 9 (Sur.) 20W Map No. _____
 Operator Francis Oil & Gas
 Well No. 2 Farm Gish
 Elev. 2249 Location C S L SW SW

330 Ft. From S Line SW
660 Ft. From W Line Quarter

1st. Report _____

Completion JAN 23 1953

Remarks _____

Speer Drlg. & Contr.

Spudding Date 12-1-52

Drlg. Data Oil well TD 3785

8" @ 192 Anhy 1686 Heeb. 3447

Lans. 3488 DST 3636-51 open 50 min.

Rec. 230' mud 180' socm 300' wtr. 0#

ReArb. 3773 Arb. 3777 TD 3782 5" @ 3778

CO to 3782 FU 2600' oil 3 hr.

S/ 21 boph 5 hr. DD 3785 = S/ 38 boph

3 hr. Comp. 3000 boph

J. G. McGEHEE