

FORM 51

Section 36 Township 9 Range 20WWell No. #2 GishCompany Continental Oil

NORTH

SOUTH

WEST

EAST

0

14

Rooks

KANSAS ✓

Sec. 36 Twp. 9 R. 20WWell No. #2 Gish FarmContinental Oil Company


Contractor

Ft. from N. Line

330 Ft. from S. Line330 Ft. from E. Line

Ft. from W. Line

SE SE SW

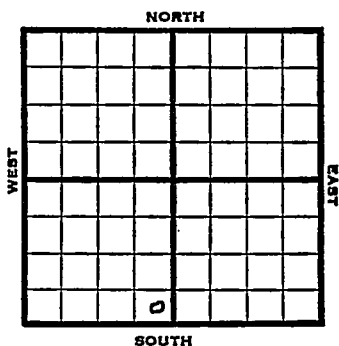

1953

Elev. 2259'

REPORT

8/12

Spud 8-9-53

8" @ 267'

Anhy 1693'

Drlg 2450'

8/19

Spud 8-9-53

D & A

TD 3882

8" @ 267'

Anhy 1693

Heeb 3488

Lans 3529

Cong 3786

TD 3882

D & A

ABANDONED

County	Rooks	State	Kansas
--------	-------	-------	--------

Sec.	36	(Blk. Twp.)	9	(Sur. Rge.)	20 W	Map No.
------	----	----------------	---	----------------	------	---------

Operator Continental Oil

Well No. 2 Farm Gish

Elev.	2259	Location	SE SE S W
-------	------	----------	-----------

ABANDONED

330 Ft. From S Line SW

330 Ft. From E Line Quarter

1st. Report

Completion AUG 19 1953

Remarks

Spudding Date 8-9-53

Drig. Data D & A TD 3882

8" @ 267 Anhy 1693 Heeb. 3488

Lans. 3529 Cong. 3786 TD 3882

D & A

J. G. McGEHEE