


Section 36 Township 9 Range 20W
Well No. 4 Gish "B"
Company Francis O&G

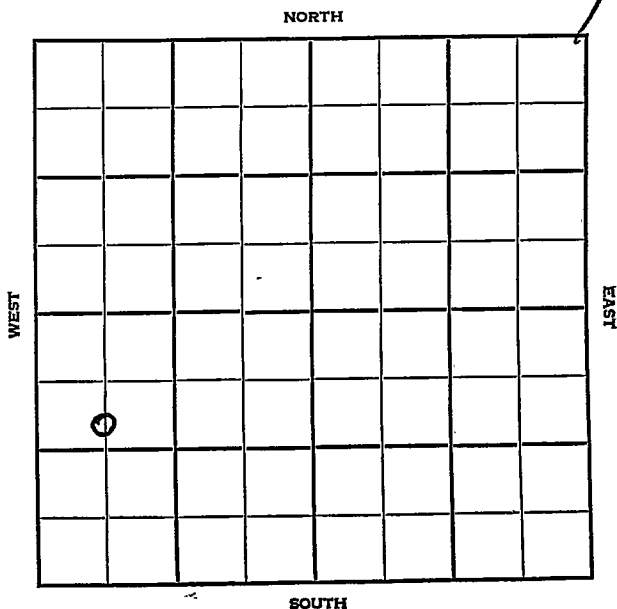

Rooks

KANSAS

SEC.	TWP.	R.
36	9	20 W

WELL NO.

4 Gish "B"

FARM

COMPANY

Francis Oil & Gas

CONTRACTOR

K & E Drlg.


Marcotte Pool

990 Ft. from N. Line

Ft. from S. Line

Ft. from E. Line

660 Ft. from W. Line

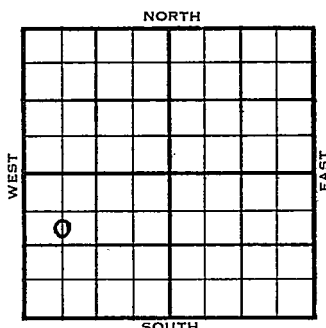C S $\frac{1}{2}$ NW SW

1955

ELEVATION

2248'

REPORT

2/2

Spud ~~12-30-54~~ 12-30-54
8" @ 213 WOC

2/16

Spud 12-30-54

D & A

TD 3861'

8" @ 213'

Heeb 3478' Tor 3500' Lans 3518'

B KC 3726' Cong 3777'

DST 3724'-3840' opn 1 hr, rec 180' socm

120' rotary mud, 1100# Ch Cong. 3798'


TD 3861'

D & A

ABANDONED

FABEN GILSTRAP

County _____ Rooks _____ State Kansas
 Sec. 36 (Blk. 9 (Sur. 20W Map No. _____
 (Twp.) (Rge.)
 Operator Francis Oil & Gas
 Well No. 4 Farm Gish "B"
 Elev. 2248 Location C S $\frac{1}{2}$ NW SW

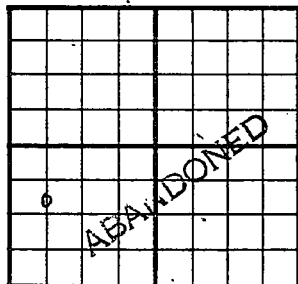

990 Ft. From N Line SW
660 Ft. From W Line Quarter
 Ist. Report _____
 Completion FEB 16 1955
 Remarks Marcotte Pool
K & E Drlg. - Contr.
 Spudding Date 12-30-54

Drlg. Data D & A TD 3861
8" @ 213 Heeb. 3478 Tor. 3500
Lans. 3518 B KC 3726 Cong. 3777
DST 3724-3840 open 1 hr. Rec. 180' socm
120' rotary mud 1100# Ch. Cong. 3798
TD 3861

D & A

FABEN GILSTRAP