


Graham

KANSAS

SECTION 36 TOWNSHIP 9S RANGE 22W

WELL NO. #1 Wolf

COMPANY Woodman-Iannitti

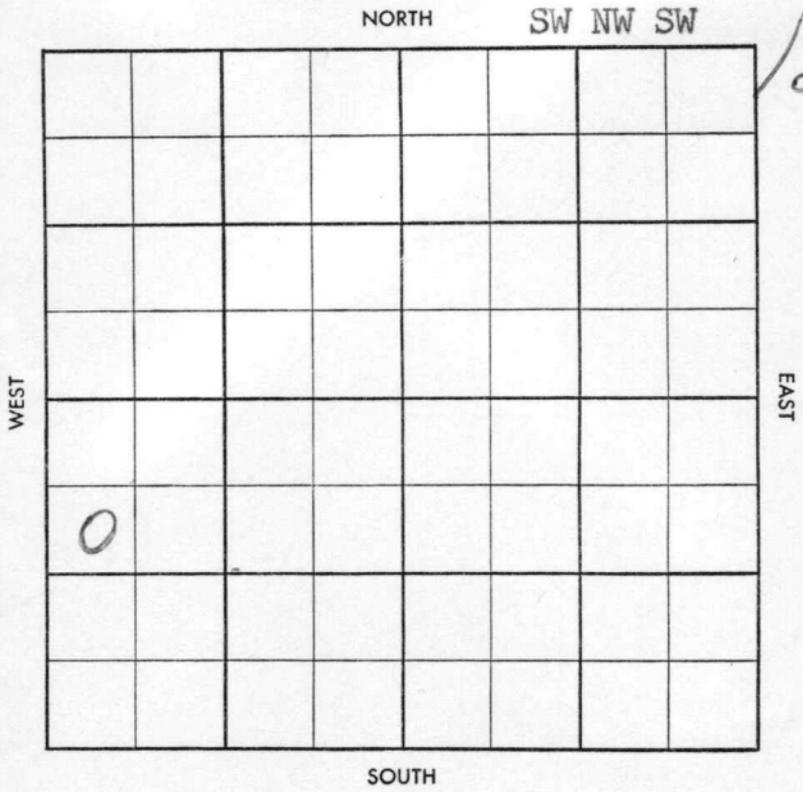

Graham

KANSAS

SEC. 36	TWP. 9 S	R. 22 W
------------	-------------	------------

WELL NO. # 1 Wolf FARM

COMPANY Woodman-Iannitti

CONTRACTOR

Wildcat


_____ FT. FROM N. LINE

1800 _____ FT. FROM S. LINE

_____ FT. FROM E. LINE

330 _____ FT. FROM W. LINE

SW NW SW

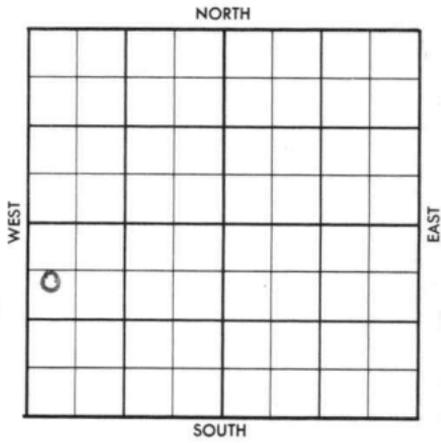

SDX-Offset

1957	ELEVATION	REPORT
------	-----------	--------

9/11

8" @ 190'
Drlg. 2990'
Anhy 1805'

(FR Tkt)

WILDCAT

SEP 13 1957
M. W.

FORM 513 SUNRAY

2330 DF

County Graham

Elev. 2333 RB

Sec. 36

Twp. 9S

Rge. 22W

Company Woodman-Iannitti

Farm Name Wolf

No. 1

Co.

Lse.

No.

Sec.

T.

R.

TOPS

DEPTH

LOG

DATUM

Loc. in Sec.

Anh.	1805		
T.P.			
H.			
Tr.			
Dg.			
Bl.			
L.			
K.C.			
B.K.C.			
Ce.			
C.			
M.			
M.			
K.			
Mz.			
Me.			
V.			
S.			
S.			
A.			
R.			
Pe.			
G.			
T.P.			

SW NW SW

1800' fsl x

330' fwl

Geol.

Contr.

Pool

~~Red Line~~

Wildcat

FIRST REPORT
SEP 11 1957

Date Comm.

SDX-OFFSET

8" @ 190, Drlg. 2990

Red-Line

4 5

FORM 513 SUNRAY

2330 DF

County Graham

Elev. 2333 RB

Sec. 36 Twp. 9S

Rge. 22W

Woodman-Iannitti

Wolf

No. 1

	TOPS	DEPTH	LOG	DATUM	Loc. in Sec.
Anh.		1805			SW NW SW
TP.					
H.		3523			1800' fsl x
Tr.		3540			330' fwl
Dg.					
Bl.					
L.		3559			Geol.
K.C.					Contr.
B.K.C.		3795			
Ce.					
C.					
M.					Pool
M.					Wildcat
K.					
Mz.					
Ma.					
V.					
S.					
S.					ABANDONED
A.					
R.					
PE.					
G.					
TD.		3866			EPID

Date Comm.

SOX OFFSET

8" @ 190, Drlg. 2990 SEP 18 57 DST 3561-2

3620 1hr 190' SW BHP 1160/20"

DST 2635-65 1hr 105' SW BHP

1070/20" DST 2680-3745 1hr 185'

Sl yocm BHP 1160/20 i no log

DBA