
Graham KANSAS

SECTION 36 TOWNSHIP 9 RANGE 23W

WELL NO. #3 LaCerte "C"

COMPANY Petroleum Inc.

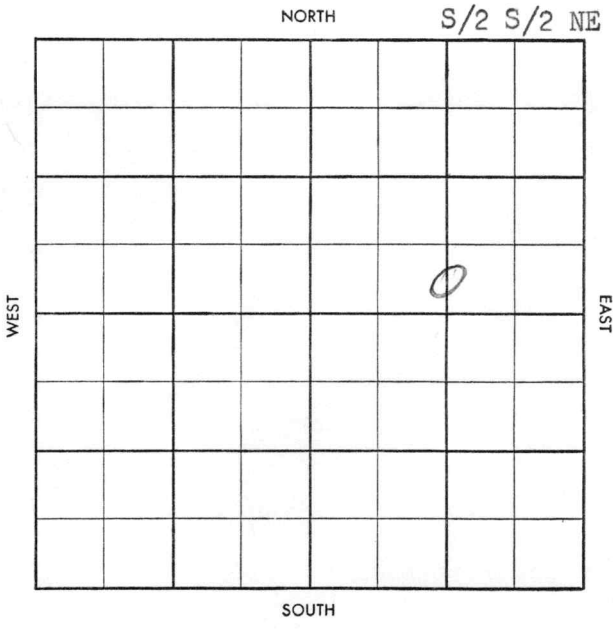

8

FORM 504-3 SUNRAY

S-513-A

CO. Graham ELEV.

SEC. 36 TWP. 9 RGE. 23W

COMPANY Petroleum Inc. NO. 3

FIRST REPORT

OCT 30 57

FARM LaCerte "C"

LOC. S/2 S/2 NE

GEOL.

CONTR. Garvey Tools #3

POOL Vesper

SPUD 10-26-57

8" @ 245 w/200, Drlg. 2652.

CO. LSE. NO. SEC. TWP. RGE.

S-513-A

CO. Graham ELEV. 2392 DF

SEC. 36 TWP. 9 RGE. 23W

COMPANY Petroleum Inc. NO. 3

COMPLETE

JAN 22 '58

FARM LaCerte "C"

LOC. S/2 S/2 NE

GEOL.

CONTR. Garvey Tools #3

POOL Vesper

SPUD 10-26-57

TD 4130

CO. LSE. NO. SEC. TWP. RGE.

8" @ 245 w/200, Drlg. 2652. NOV 6 '57

A 1840 TP 3407 Hb 3630
TR 3653 Lsg 3665 DST
3658-3742 60" 210' wtry M
BHP 1000/20" DST 3738-60
60" 21' M BHP 640/20" DST
3815-35 60" G/20" rec 3247
grsy oil BHP 1080/20" DST
3850-55 60" G/30" 1545'
gassy oil BHP 760/20

Bkc 3841 DST 3950-3900
60" 45'm BHP 0/20 Mdt 3975
Cong 4040 ⊄4089 NOV 13 '57
RTD 4130 +½" 3990/200
CO 3922 16/3840-44 24/3824
-30 ⊄10Boph NW NT 4500A
⊄22Boph NW wt POP

NOV 20 '57 NOV 27 '57 DEC 4 '57 DEC 11 '57 DEC 18 '57
DEC 26 '57 JAN 2 '58 JAN 8 '58 JAN 15 '58 JAN 22 '58

P 22Boph 2600A
Phy P 61Bopd NW
on 410