

Graham

DX 78-1


KANSAS

Section 36 Township 9 Range 24W

Well No. #1 Mullaney

Company Herndon Drlg.

NORTH

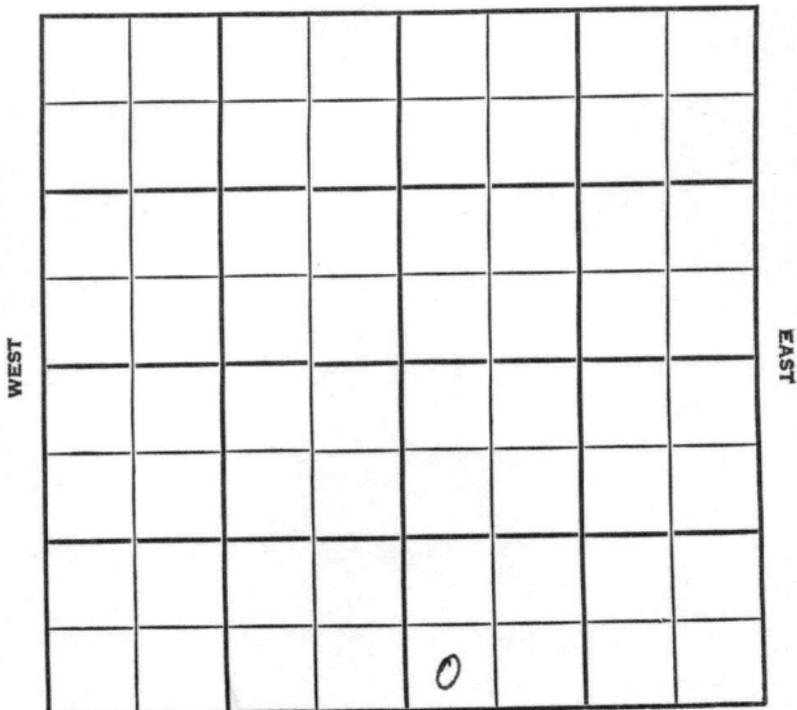

SOUTH

HOT FILE

Graham

KANSAS

| | | |
|------|------|------|
| SEC. | TWP. | R. |
| 36 | 9 | 24 W |

WELL NO.

1 Mullaney

FARM

COMPANY

Herndon Drlg.

CONTRACTOR

Co. tools.


Wildcat

_____ Ft. from N. Line

330 _____ Ft. from S. Line

_____ Ft. from E. Line

330 _____ Ft. from W. Line

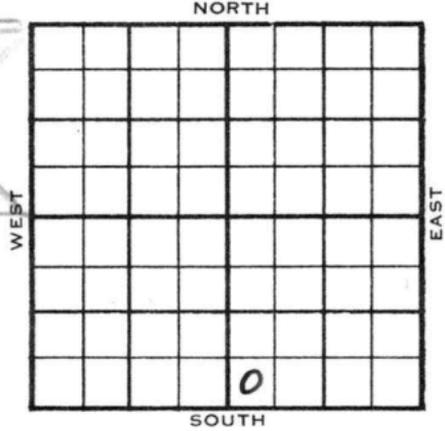

SW SW SE
MCPC has NE 1/4 of 35.

| 1955 | ELEVATION | REPORT |
|------|-----------|--|
| | 2448' | |
| 2/23 | | Spud 2-21-55 |
| 3/3 | | Set 8" @ 250 |
| | | Drlg. 3470' (Ltr-Gilstrap) |
| 3/10 | | Heeb 3756 Tor. 3776 Lans 3791 |
| | | DST 3816-30 open 1 hr rec 10' SOCM |
| | | 30#. DST 3914-32 open 1 hr rec 145' |
| | | MSW, 870#. DST 3943-62, open 1/2 hr, |
| | | rec 10' mud. DST 3963-83 open 1 hr |
| | | rec 50' wtr. 190#. Marm. 4138' |
| | | Miss. 4300', Viola 4414, Arb. 4486' |
| | | TD 4500' Ran Schl. D & A |
| 3/9 | | Spud 2-21-55 (Ltr-Gilstrap) |
| | | D & A |
| | | TD 4500' |
| | | 8" @ 250' |
| | | Heeb 3756', Tor. 3776' Lans 3791' |
| | | DST 3816'-30' opn 1 hr, rec 10' socm |
| | | 30# |
| | | DST 3914'-32' opn 1 hr, rec 145' msw |
| | | 870# |
| | | DST 3943'-62' opn 1/2 hr, rec 10' Mud |
| | | DST 3963'-83' opn 1 hr, rec 50' wtr, |
| | | 190# Marm 4138' Miss 4300' Viola 4414' |
| | | Arb. 4486' |
| | | TD 4500' |
| | | ABANDONED |
| | | D & A |

