


Section 4 Township 9 Range 16-W

Well No. #4 Holly Cross

Company C. SO

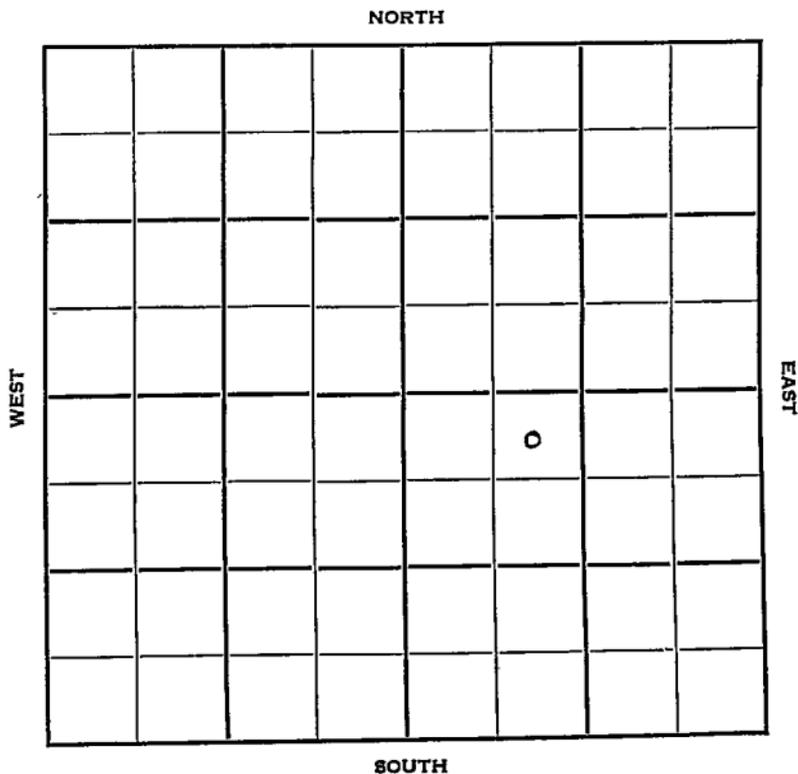

Rooks

KANSAS

Sec. 4 Twp. 9 R. 16W ✓

Well No. #4 Holly Cross Farm

G. S. O. Company

Contractor

Layton


330' Ft. from N. Line

Ft. from S. Line

Ft. from E. Line

990' Ft. from W. Line

NE NW SE

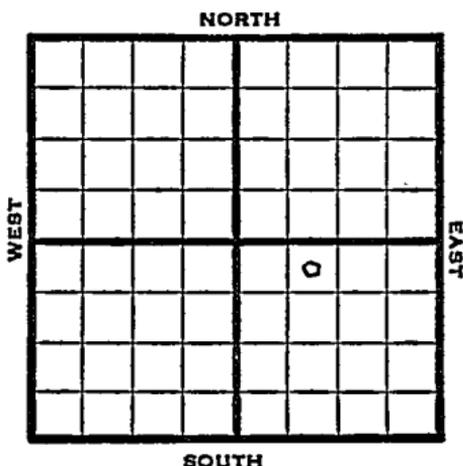

1950

Elev 1981

REPORT

5/31

Location

7/12

8" @ 240

Heeb 3051

Dodge 3071

Lans 3091

TD 3446

5" @ 3446

28/3299-3306, 23/3206-14, 21/3168-73,

24/3153-62, 28/3143-50, 21/3168-73,

21/ 3126-33, 17/3096-3100, 25/3086-92

3000 acid

Pump 23 B0 120 bwpd

Arb 3416

Comp 43 bo 70 bwpd

Completed

**COMPLETED**

Kan<sup>as</sup>

Map No. \_\_\_\_\_ Sec. 4 \_\_\_\_\_ Twp. 9 \_\_\_\_\_ R. 16W

Well No. 4 Holly Cross \_\_\_\_\_

C. S. O. \_\_\_\_\_ Company

\_\_\_\_\_ Contractor

NE NW SE

**SECTION PLAT**

330 Ft. from N. Line

\_\_\_\_\_ Ft. from S. Line

\_\_\_\_\_ Ft. from E. Line

990 Ft. from W. Line

FIRST REPORT			
		o	

**Rocks**

Location X

Rig up \_\_\_\_\_

Drilling and Remarks:

**RECORD**

Cased \_\_\_\_\_ in., \_\_\_\_\_ ft.

Sand \_\_\_\_\_

Gas \_\_\_\_\_

Oil \_\_\_\_\_

Total Depth \_\_\_\_\_

**PRODUCTION**

1st 24 hrs. Nat. \_\_\_\_\_

1st 24 hrs. after shot \_\_\_\_\_

Gas \_\_\_\_\_ Cu. Ft.

Dry Hole \_\_\_\_\_

Abandoned \_\_\_\_\_

Date

MAY 31 1950<sub>19</sub>

J. E. TYRA Scout

Kansas

Layton Pool

Map No. \_\_\_\_\_ Sec. 4 Twp. 9 R. 16WWell No. 4 Holly Cross

\_\_\_\_\_ Cities Service \_\_\_\_\_ Company

\_\_\_\_\_ Contractor

NE NW SE


El. 1981

## SECTION PLAT

330 Ft. from N. Line

\_\_\_\_\_ Ft. from S. Line

\_\_\_\_\_ Ft. from E. Line

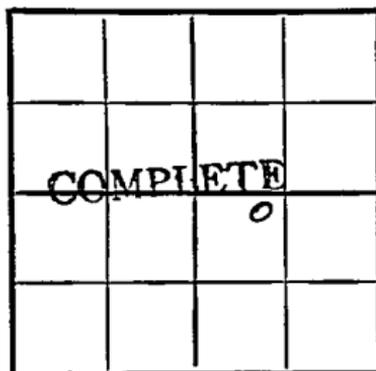990 Ft. from W. Line

Rooks County

Location \_\_\_\_\_

Rig up \_\_\_\_\_

## Drilling and Remarks:

8" @ 240

Heeb. 3051

Dodge 3071

Lans. 3091

TD 3446

5" @ 3446

28/ 3299-3306

## RECORD

Cased \_\_\_\_\_ in., \_\_\_\_\_ ft.

Sand \_\_\_\_\_

Gas \_\_\_\_\_

Oil \_\_\_\_\_

Total Depth 3446

## PRODUCTION ,

1st 24 hrs. Nat. \_\_\_\_\_

1st 24 hrs. after shot \_\_\_\_\_

Gas \_\_\_\_\_ Cu. Ft.

Dry Hole \_\_\_\_\_

Abandoned \_\_\_\_\_

Date

JUL 12 1950 19J. E. TYRA

Scout

33/ 3206-14

21/ 3168-73

24/ 3153-62

28/ 3143-50

21/ 3168-73

21/ 3126-33

17/ 3096-3100

25/ 3086-92

3000 acid


Pump 25 bo 120 bwpd

Arb. 3416

Comp. 43 bo 70 bwpd

Misc.
Pierce Map
France Map
Tracings
Land Wall Map
Land Small Map
Scout Cards

1950  
M

 

LOUIS ET

APPENDIX

INDEX OF

APPENDIX