

Section 4 Township 9 Range 18 W
Well No. # 1 Yohe "A"
Company B & B Drllg.

A 10x10 grid with 'NORTH' at the top, 'SOUTH' at the bottom, 'WEST' on the left, and 'EAST' on the right. The number '0' is in the bottom-right cell.

Rooks

SEC.	TWP.	R.
4	9	18 W

WELL NO.

1 Yohe "S"

FARM

COMPANY

B & B Drlg.

CONTRACTOR

~~SEMY~~

B & B Drlg.

Semi-Wildcat

Ft. from N. Line

330

Ft. from S. Line


Ft. from E. Line

990

Ft. from W. Line

SE SW SE

Lion - DHM

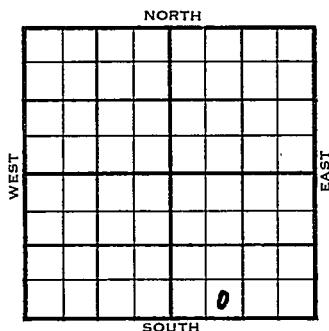

	ELEVATION	REPORT
1953	2039'	

9/30

MIR

10/7

8" @ 153 Anhy 1395' Top 2962'
 Heeb 3175' Tor 3196' Lans 3215'
 DST 3240-60, 1 hr, 95' M 1100#
 Drlg. 3260'

10/14

Spud 9-29-53
 D&A

TD 3624

8" @ 153'

Anhy 1395', Top 2962', Heeb 3175', Tor
 3196', Lans 3215',

DST 3240-60, opn 1hr., rec. 95' mud,
 1100#

DST 3283-3308, opn 1 hr., rec. 1380'
 wtr, 1040#

DST 3308-33, opn 1hr., rec. 1140'
 wtr, 1020#

Cong 3472

TD 3624

D&A

ABANDONED


J. G. McGEHEE

County _____ Rocks _____ State Kansas
 Sec. 4 (Blk.) 9 (Sur.) 18W Map No. _____
 (Twp.) _____ (Rge.) _____

Operator B & B Drlg.

Well No. 1 Farm Yohe "A"

Elev. 2039 Location SE SW SE

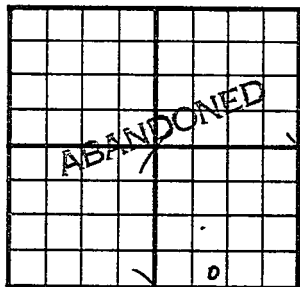

330 Ft. From S Line SE

990 Ft. From W Line Quarter

1st. Report

Completion OCT 14 1953

Remarks Semi Wildcat

B & B Drlg. - Contr.

Spudding Date 9-29-53

Drlg. Data D & A TD 3624

8" @ 153 Anhy 1395 Top. 2962

Heeb. 3175 Tor. 3196 Lans. 3215

DST 3240-60 open 1 hr. Rec. 95' mud

1100# DST 3283-3308 open 1 hr.

Rec. 1380' wtr. 1040# DST 3308-33

open 1 hr. Rec. 1140' wtr. 1020#

Cong. 3472 TD 3624

D & A

J. G. McGEHEE