

Rooks

**KANSAS**

4

9


19W

SECTION \_\_\_\_\_ TOWNSHIP \_\_\_\_\_ RANGE \_\_\_\_\_

WELL NO. #1 McClellan

COMPANY Eldorado Ref. Co. *//*

NORTH

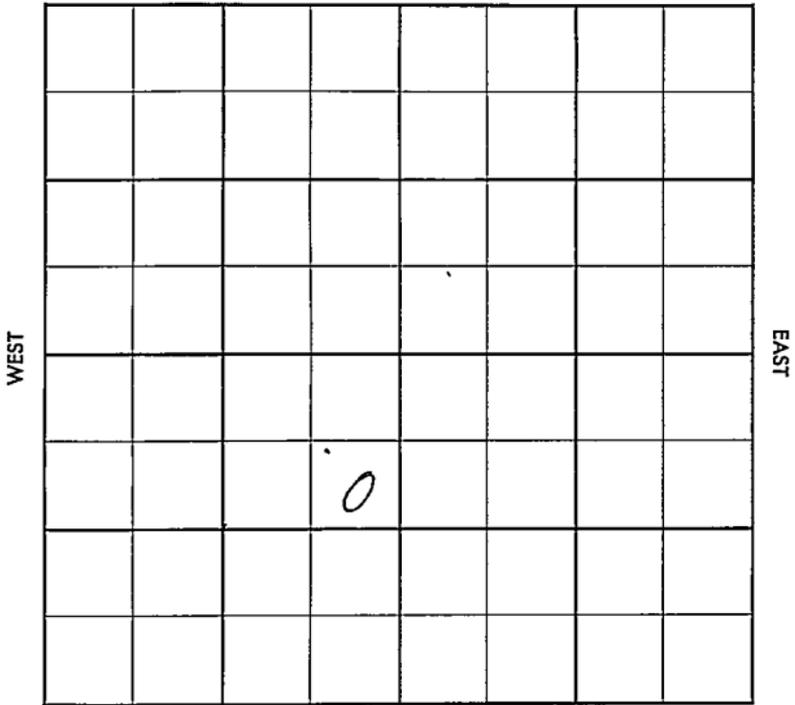

SOUTH

County Rooks Elev. \_\_\_\_\_  
 Sec. 4 Twp. 9 Rge. 19W  
 Company Eldorado Ref. Co.  
 FarmName McClellan No. 1

TOPS	DEPTH	LOG	DATUM	Loc. in Sec.
Anh.		11405		SE NE SW
TP.				
H.				
Tr.				
Dg.				
BL.				
L.				Geol. _____
K.C.				Contr. _____
B.K.C.				Walter Tools
Ce.				
C.				Pool
M.				Webster
M.				
K.				
Mz.				
Ma.				
V.				
S.				
S.				FIRST REPORT
A.				
R.				
PE.				
G.				SEP 26 '56
T.D.				

Date Comm. 9-19-56  
8" @ 228 w/150, Drlg. 2990

2001 A 1 100

R. G.



Co.  
Sec.  
No.  
Sec.  
T.  
R.

Co.

Loc.

No.

Sec.

T.

R.

County Rooks Elev. 1988 DF  
 Sec. 4 Twp. 9 Rge. 19W  
 Company Eldorado Ref. Co.  
 FarmName McClellan No. 1

TOPS	DEPTH	LOG	DATUM
Anh.		1405	
Tp.			
H.	3152		
Tr.	3173		
Dg.			
Bl.			
L.	3188		
K.C.			
B.M.C.			
Ce.			
C.	3398		
M.			
M.			
K.			
Mz.			
Me.			
V.			
S.			
S.			
A.	3463		
R.			
PE.			
G.			
TD.	3472		

Loc. in Sec. SE NE SW  
 Geol. \_\_\_\_\_  
 Contr. \_\_\_\_\_  
Walter Tools  
 Pool \_\_\_\_\_  
Webster  
 ABANDONED  
 OCT 3 '56

Date Comm. 9-19-56

8" @ 228 w/150, Drlg. 2990 OCT 3 '56

*DCA*