


Section 4 Township 9 Range 19W

Well No. 2 McClellan

Company Westgate-Greenland

2

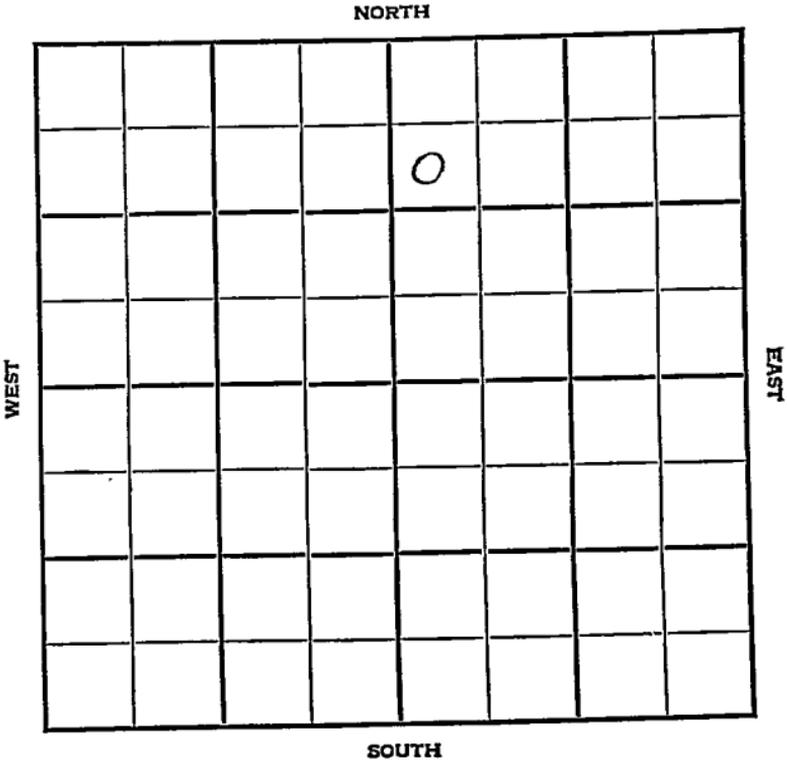



Sec. 4 Twp. 9 R. 19W


Well No. #2 McClellan Farm

Westgate-Greenland Company

Chandler Pool

NORTH

990' Ft. from N. Line

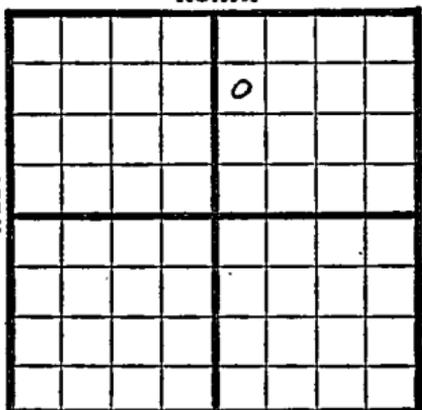

_____ Ft. from S. Line

_____ Ft. from E. Line

330' Ft. from W. Line

SW NW NE

SOUTH

1948

Eli 1994

R E P O R T

7/28

8" @ 159'
Drlg. 1241'

8/4

Drlg. 3083'

8/11

3292 fsg

8/18

Arb. 3420'
TD 3422'
5"@ 3422'

8/25

TD 3423'
1300' oil

9/1

Arb. 3420'
5"@ 3422'
TD 3423½ 500 acid
Echo Pot 3000 oil
27° Gr.

Comp

COMPLETED

Rooks County Kansas State

Map No. _____ Sec. 4 Twp. 9 R. 19W

Well No. 2 McClellan

Westgate-Greenland Company

FIRST REPORT Contractor

SW NW NE

SECTION PLAT

990 Ft. from N. Line

_____ Ft. from S. Line

_____ Ft. from E. Line

330 Ft. from W. Line

				o			

Chandler Pool

Remarks:

8" @ 159 drlg. 1241

Date
JUL 28 1948

Scout S. J. LEWIS

Rooks County Kansas State

Map No. 65 Sec. 4 Twp. 9 R. 19W

Well No. 2 McClellan

Westgate-Greenland Company

COMPLETE

Contractor

SW NW NE

E. 1994

SECTION PLAT

990 Ft. from N. Line

_____ Ft. from S. Line

_____ Ft. from E. Line

330 Ft. from W. Line

Chandler Pool

Remarks:

Ca 43420

5' @ 3422

7' @ 3423 1/2

500 @ 3420

Echrt Pz 43000 oil

27 2/3

Date
SEP 1 1948

Scout S. J. LEWIS