
FORM 51 10M 7-48 PETROL

KANSAS Rooks

Section 4 Township 9 Range 19-W

Well No. #4 McClelland

Company Westgate-Greenland
Barry Pool

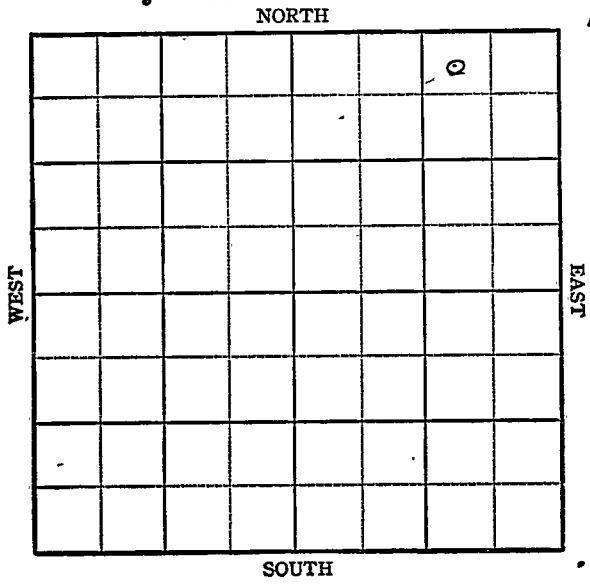

FORM 252-A
5M 10-48 PETROL

KANSAS Rooks ✓

Sec. 4 Twp. 9 R. 19W

Well No. #4 McClelland Farm

Westgate-Greenland Company

Barry Pool


330' Ft. from N. Line

Ft. from S. Line

990' Ft. from E. Line

Ft. from W. Line

NW NE NE

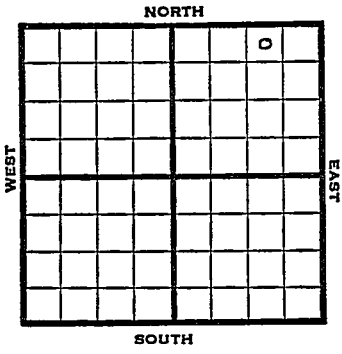


| 1948 | Elev. 1971' REPORT |
|---|---|
| 12/1 | 10" @ 250'<br>Heebner 3113'<br>Lans. 3154'<br>Drlg. 3210' |
| 12/8 | Arb. 3398'<br>TD 3402<br>7"@ 3400' |
| 12/15 | TD 3403'<br>Swb 2 bbls oil PH |
| 12/22 | Arb 3398'<br>7" @ 3400'<br>2000 acid<br>Echo Pot. 3000 oil<br>Gr. 29°<br>TD 3403' |

COMPLETED

Form 26 200 Bks. 9-48 Petrol

Kansas

Barry Pool

Map No. ____ Sec. 4 Twp. 9 R. 19W

Well No. 4 McClelland

Westgate-Greenland Company

FIRST REPORT Contractor

NW NE NE


330 Ft. from N. Line

____ Ft. from S. Line

990 Ft. from E. Line

____ Ft. from W. Line

SECTION PLAT

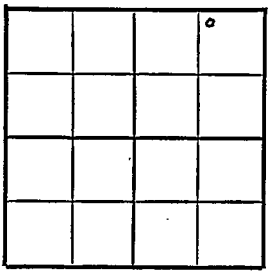

Rooks County

Location ____

Rig up ____

Drilling and Remarks:

10" @ 250

Heebner 3113'

Lans. 3154

drlg. 3210

RECORD

Cased ____ in., ____ ft.

Sand ____

Gas ____

Oil ____

Total Depth ____

PRODUCTION

1st 24 hrs. Nat. ____

1st 24 hrs. after shot ____

Gas ____ Cu. Ft.

Dry Hole ____

Abandoned ____

Date

DEC 1 1948 19

S. J. LEWIS Scout

Form 26 200 Bks. 9-48 Petrol

Kansas

Webster Pool

Map No. 6 5 Sec. 4 Twp. 9 R. 19W

Well No. 4 McClelland


Westgate-Greenland Company

COMPLETE Contractor

NW NE NE

E. 1991

SECTION PLAT

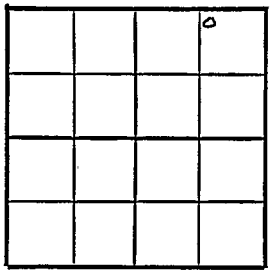

330 Ft. from N. Line

Ft. from S. Line

990 Ft. from E. Line

Ft. from W. Line

Rooks County

Location

Rig up

Drilling and Remarks:

Cr 3898

7" @ 3408

200 Acid

Echo Pet 3000 gal

292 Gl

RECORD

Cased in., ft.

Sand

Gas

Oil

Total Depth 3408

PRODUCTION

1st 24 hrs. Nat.

1st 24 hrs. after shot

Gas Cu. Ft.

Dry Hole

Abandoned

Date

DEC 22 1948 19

S. J. LEWIS Scout