Rooks


FORM 51 10M 7-48 PETROL

KANSAS

Section 4 Township 9 Range 19-W

Well No. #5 McClellan

Company Westgate-Greenland
Webster

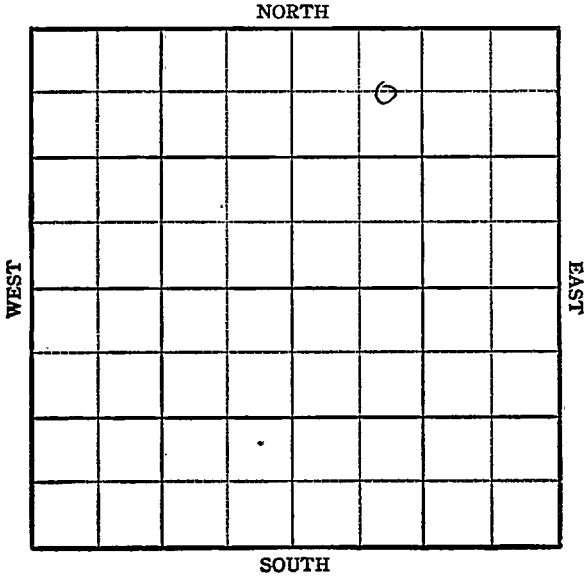

FORM 252-A
5M 10-48 PETROL

KANSAS

Rooks

Sec. 4 Twp. 9 R. 19W

Well No. #5 McClellan Farm

Westgate-Greenland Company

Webster Pool


660' Ft. from N. Line

Ft. from S. Line

Ft. from E. Line

990' Ft. from W. Line

C E L NW NE

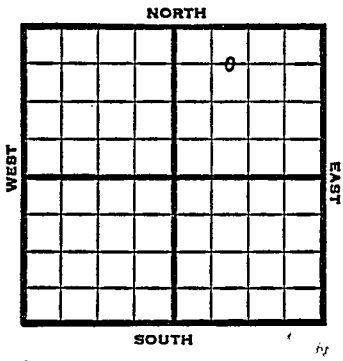

1948	Elev. 1996' REPORT
12/8	10" @ 245' Drlg. 1100'
12/15	Drlg 3115'
12/22	Lans. 3190' Arb 3472' TD 3484' ABANDONED

Form 26 200 Bks. 9-48 Petrol

Kansas

Webster Pool

Map No. ____ Sec. 4 Twp. 9 R. 19W

Well No. 5 McClellan

Westgate-Greenland Company

FIRST REPORT Contractor

C E L NW NE

660 Ft. from N. Line


____ Ft. from S. Line

____ Ft. from E. Line

990 Ft. from W. Line

Rooks County

SECTION PLAT

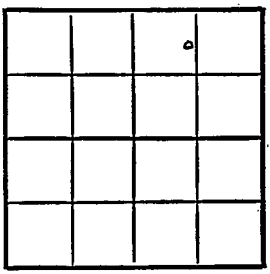

Location

Rig up

Drilling and Remarks:

10" @ 245
drlg. 1100

RECORD

Cased ____ in., ____ ft.

Sand

Gas

Oil

Total Depth

PRODUCTION

1st 24 hrs. Nat.

1st 24 hrs. after shot

Gas ____ Cu. Ft.

Dry Hole

Abandoned

Date

DEC 8 1948 19

S. J. LEWIS Scout

Form 26 200 Bks. 9-48 Petrol

Kansas

Webster Pool

Map No. 65 Sec. 4 Twp. 9 R. 19W

Well No. 5 McClellan

Westgate-Greenland Company

ABANDONED Contractor

C E L NW NE

660 Ft. from N. Line


Ft. from S. Line

Ft. from E. Line

990 Ft. from W. Line

Rooks County

SECTION PLAT

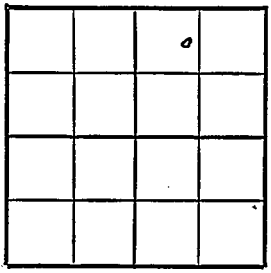

Location

Rig up

Drilling and Remarks:

Lane 3190

Cir 3472

RECORD

Cased in., ft.

Sand

Gas

Oil

Total Depth 3487

PRODUCTION

1st 24 hrs. Nat.

1st 24 hrs. after shot

Gas Cu. Ft.

Dry Hole

Abandoned

Date

DEC 22 1948 19

S. J. LEWIS Scout