

KANSAS


Rocks

Section 4 Township 9 Range 19WWell No. #1 McClellanCompany Westgate-Greenland
Wildcat

NORTH

WEST

EAST

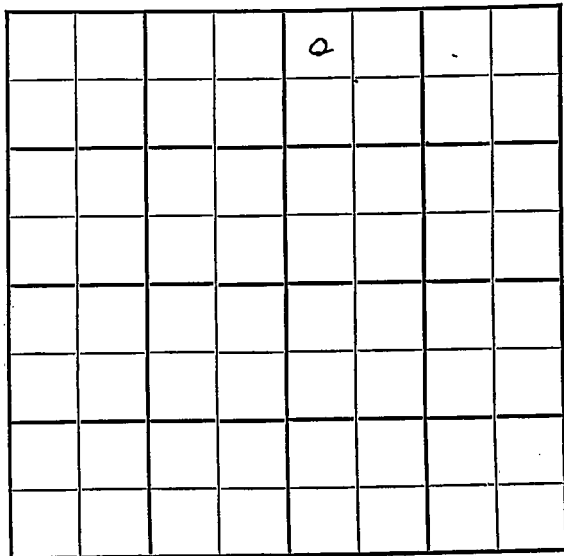

SOUTH

Sec. 4 Twp. 9 R. 19W

Well No. #1 McClellan Farm


Westgate-Greenland Company
Wildcat

330 Ft. from N. Line

 Ft. from S. Line

 Ft. from E. Line

330 Ft. from W. Line

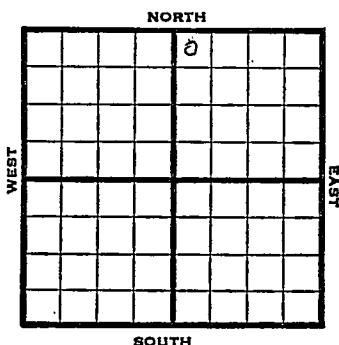

NW NE

1948 Elev. 2008' REPORT

4/14	Location
4/21	RUR
4/28	8" @ 152'
.	Drlg. 2160'
5/5	Lansing 3204'
	Arb. 3442'
	TD 3449'
	DST 3442-49' opn 1/2 hrs. 240' oil
	5" @ 3442'
	RUST
5/12	Swb 5 bbls oil 1 hr.
5/19	500 Acid
	Pump 18 bbls oil PH 3 hrs.
5/26	"
6/1	"
6/9	"
6/16	"
6/23	"

OVER

1948

6/30

Arbuckle 3437'

5" @ 3437'

500 Acid

Pump 314 oil & 2% W Pot.

Gr. 280

TD 3444'


COMPLETED

Wildcat

Form 26—200 Bks.—1-48—Palace
KansasMap No. _____ Sec. 4 Twp. 9 R. 19WWell No. 1 McClellanWestgate-Greenland Company**FIRST REPORT** Contractor

NW NE

SECTION PLAT

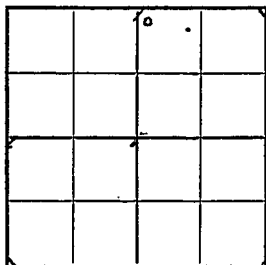330 Ft. from N. Line Ft. from S. Line Ft. from E. Line330 Ft. from W. LineRooks CountyLocation XRig up

Drilling and Remarks:

RECORD

Cased in., ft.Sand Gas Oil Total Depth

PRODUCTION

1st 24 hrs. Nat. 1st 24 hrs. after shot Gas Cu. Ft.Dry Hole Abandoned

Date

APR 14 194819S. J. LEWIS Scout

Map No. 65 Sec. 4 Twp. 9 R. 19W

Well No. 1 McClellan

Westgate-Greenland Company

COMPLETE

Contractor

NW NE

E12008


SECTION PLAT

330 Ft. from N. Line

 Ft. from S. Line

 Ft. from E. Line

330 Ft. from W. Line

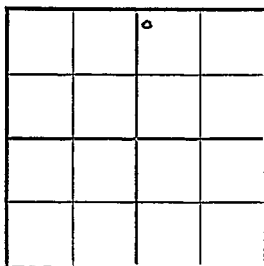

Rooks County

Location

Rig up

Drilling and Remarks:

CR 83437

5' 10" 83437

500 @ cu'

Prod 814 oil + 2 7/8" H₂O

P2Y

28 2/3"

RECORD

Cased in., ft.

Sand

Gas

Oil ✓

Total Depth 3444

PRODUCTION

1st 24 hrs. Nat.

1st 24 hrs. after shot

Gas Cu. Ft.

Dry Hole

Abandoned

Date

JUN 30 1948 19 S. J. LEWIS Scout