

Section 4 Township 9 Range 19-WWell No. #1 RostocilCompany Skelly

NORTH

			0				

SOUTH

WEST EAST

KANSAS

Rooks



Sec. 4 Twp. 9 R. 19W

Well No. #1 Rostocil Farm

Skelly Company

Chandler Pool


330' Ft. from N. Line

 Ft. from S. Line

330' Ft. from E. Line

 Ft. from W. Line

NE NW

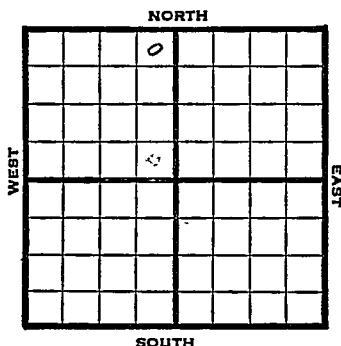

1948

Elev. 2011⁶ REPORT

6/30 13" @ 196'
WOC

7/8 8" @ 1450'
Drlg 2150'

7/14 Drlg 3044'

7/21 Lansing 3202' ...
Arbuckle 3441-43'
TD 3443'
5" @ 3442'
RUST "

7/28

8/4 Pump 120 bbls. oil in 8 hrs.

8/11 Arbuckle 3441'
5" @ 3442'
TD 3443'
500 acid
Depth Pot. 3000 oil
Gr. 28°

COMPLETED

Map No. _____ Sec. 4 Twp. 9 R. 19W

Well No. 1 Rostocil

Skelly _____ Company

FIRST REPORT

Contractor

NE NW


SECTION PLAT

330 Ft. from N. Line

_____ Ft. from S. Line

330 Ft. from E. Line

_____ Ft. from W. Line

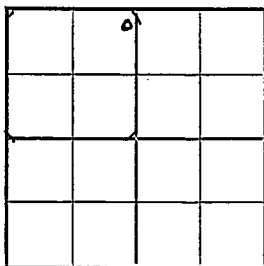

Rooks County

Location _____

Rig up _____

Drilling and Remarks: _____

13" @ 196 WOC

RECORD

Cased _____ in., _____ ft.

Sand _____

Gas _____

Oil _____

Total Depth _____

PRODUCTION

1st 24 hrs. Nat. _____

1st 24 hrs. after shot _____

Gas _____ Cu. Ft.

Dry Hole _____

Abandoned _____

Date

JUN 30 1948 19

S. J. LEWIS

Scout

Rooks County Kansas State

Map No. 65 Sec. 4 Twp. 9 R. 19W

Well No. 1 Rostocil

Skelly Company

COMPLETE

Contractor

NE NW

E. 2011
SECTION PLAT

330 Ft. from N. Line

 Ft. from S. Line

330 Ft. from E. Line

 Ft. from W. Line

Chandler Pool

Remarks:

Ca 83441

5" @ 3442

7.13443

500 acid

Depth 3000 acb

28 1/2

Date

AUG 11 1948

Scout

S. J. LEWIS