

KANSAS

Rooks



Sec. 4 Twp. 9 R. 19W

Well No. #3 Bostocil Farm

Skelly

Company


Chandler Pool

990' Ft. from N. Line

_____ Ft. from S. Line

330' Ft. from E. Line

_____ Ft. from W. Line

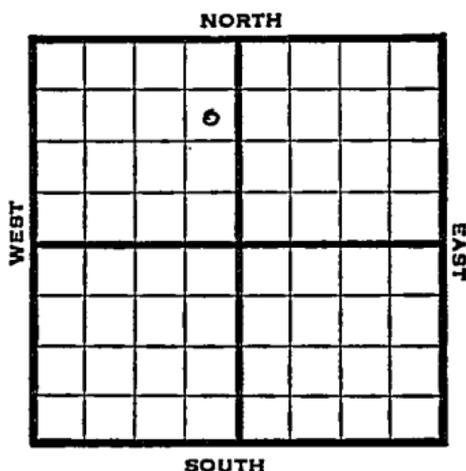

SE NE NW

1948

Eli 1998' REPORT

9/15	Location
9/21	13" @ 195'
	Drlg 1760'
9/29	Lansing 3184'
	Arb. 3425'
	TD 3428'
10/6	"
10/13	"
10/19	5" @ 3426'
	900 acid
	Pump 160 bbls oil 8 hrs.
10/27	TD 3428'
	Arb. 3425'
	5" @ 3426
	900 acid
	Echo Pot 3000 oil
	27° Gr.

Comp
COMPLETED

Rooks County Kansas State

Map No. _____ Sec. 4 Twp. 9 R. 19W

Well No. 3 Rostocil

Skelly Company

FIRST REPORT

Contractor _____

SE NE NW

SECTION PLAT

990 Ft. from N. Line

_____ Ft. from S. Line

330 Ft. from E. Line

_____ Ft. from W. Line

Chandler Pool

Remarks:

Location

Date
SEP 15 1948

Scout
S. J. LEWIS.

Map No. 65 Sec. 4 Twp. 9 R. 19W

Well No. 3 Rostocil

Skelly Company

COMPLETE

Contractor

SE NE NW

E, 1998

SECTION PLAT

990 Ft. from N. Line

 Ft. from S. Line

330 Ft. from E. Line

 Ft. from W. Line

Rooks County

Location _____

Rig up _____

Drilling and Remarks:

Per 3425
5' @ 3426
900 acid
Per 3000
275 GW

RECORD

Cased _____ in., _____ ft.

Sand _____

Gas _____

Oil

Total Depth 3428

PRODUCTION

1st 24 hrs. Nat. _____

1st 24 hrs. after shot _____

Gas _____ Cu. Ft.

Dry Hole _____

Abandoned _____

Date

OCT 27 1948

19

S. J. LEWIS

Scout