

Section 4 Township 9 Range 19W

Well No. 5 Rostocil

Company Kelly

Webster

NORTH

			0				

WEST

EAST

SOUTH

Sec. 4 Twp. 9 R. 19W

Well No. #5 Rostocil Farm

Skelly Company


Webster Pool

 Ft. from N. Line

330' Ft. from S. Line

330' Ft. from E. Line

 Ft. from W. Line

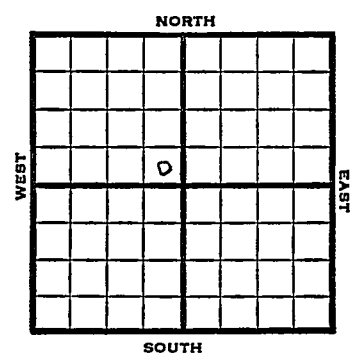

SE SE NW

1949	Elev. 2011'	REPORT
3/2	13" @ 204'	
3/8	Drlg. 2470'	
	Lansing 3444-47'	
	TD 3447'	
3/16	5" @ 3445'	
3/23	S_LM 3447'-45	
	Arbuckle 3442'	
	5" @ 3443'	
	TD 3446'	
	250 acid	
	Pump 82 bbls oil 8 hrs.	
3/30	Arb 3442'	
	5" @ 3443'	
	250 acid	
	Pump 140 oil Pot.	
	Gr. 28.8°	
	TD 3446'	
1956	COMPLETED	
1/18	O. W. P. B.	
	OTD 3447'. 5" @ 3439	PB 3404'
	36/3351-54	500 A B/14 GWPH 8 hr.
	PB 3292'	24/3282-86 S/4 BWPH 8 hr.
	PB 3250'	36/3234-40 S/5 BWPH 8 hr.
	PB 3220	48/3200-08 2250 A B/3 GO
	15 GWPH	PB 3196 24/3180-84
	24/3188-92	500 A P/23 BO 74 BW
	13 hr.	1000 A. Comp. 26 BOPD 84 BW

OVER

1956
1/18

Log: H. 3158'; Tr. 3180', L. 3200'
BKC 3413', A. 3438'
TD 3447'. Comp. 26 BOPD 84 BW

~~FIRST REPORT~~
COMPLETED

Kansas

Map No. _____ Sec. 4 Twp. 9 R. 19WWell No. 5 Rostocil_____Skelly_____Company

FIRST REPORT

_____Contractor

SE NW

SECTION PLAT

		<i>o</i>	

_____Ft. from N. Line330 _____Ft. from S. Line330 _____Ft. from E. Line_____Ft. from W. Line

Rooks County

RECORD

Location _____

Cased _____ in., _____ ft.

Rig up _____

Sand _____

Drilling and Remarks:

Gas _____

Oil _____

Total Depth _____

13" @ 204drlg. 2470

PRODUCTION

1st 24 hrs. Nat. _____

1st 24 hrs. after shot _____

Gas _____ Cu. Ft.

Dry Hole _____

Abandoned _____

Date

MAR 2 1949 19S. J. LEWIS Scout

Map No. 65 Sec. 4 Twp. 9 R. 19W

Well No. 5 Rostocil

Skelly

Company

COMPLETE

Contractor

SE NW

E. 2011


SECTION PLAT

 Ft. from N. Line

330 Ft. from S. Line

330 Ft. from E. Line

 Ft. from W. Line

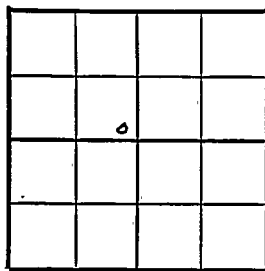

Rooks County

Location

Rig up

Drilling and Remarks:

Cu & 3442

5" C 3443

250 acial

Pump 140 oil BT

28 E. 11

RECORD

Cased in., ft.

Sand

Gas

Oil

Total Depth 3446

PRODUCTION

1st 24 hrs. Nat.

1st 24 hrs. after shot

Gas Cu. Ft.

Dry Hole

Abandoned

Date

MAR 30 1949

19

S. J. LEWIS

Scout

FORM 513 REV. SUNRAY

LOW PR

County Rooks Elev. 2011
 Sec. 11 Twp. 9 Rgs. 19W
 Company Shelby
 Farm Name Frank Rostocil No. 5

TOPS	DEPTH	LOG	DATUM	Loc. in Sec.
Anh.				SE SE NW
Tr.		3158		
H.		3180		
Tr.				
Dg.				
BL.				
L.		3200		Geol.
K.C.				Contr.
B.K.C.		3413		
Ce.				
C.				
M.				Pool
M.				Webster
K.				
Mz.				
Mq.				
V.				
S.				
S.		3436		FIRST REPORT
A				0
R.				JAN 18 '56
Pe.				
G.				
		3447		COMPLETE
TD.				

Date Comm.

OTD 3447 5" @ 3439 PB 3404

36/ 3351-54 500 A B/ 14 gwph 8 hr.

PB 3292 24/ 3282-86 S/ 4 bwph 8 hr.

PB 3250 36/ 3234-40 S/ 5 bwph 8 hr.

PB 3220 48/ 3200-08 2250 A

B/ 3 go 15 gwph PB 3196 24/ 3180-84

24/ 3188-92 500 A P/ 23 bo 74 bw

13 hr. 1000 A Comp. 26 bopd 84 bw

Co.

Use

No.

586


