KANSAS Rooks

FORM 51 10M 7-48 PETROL


Section 4 Township 9 Range 19W

Well No. 6 McClellan

Company Westgate-Greenland

Chandler

7

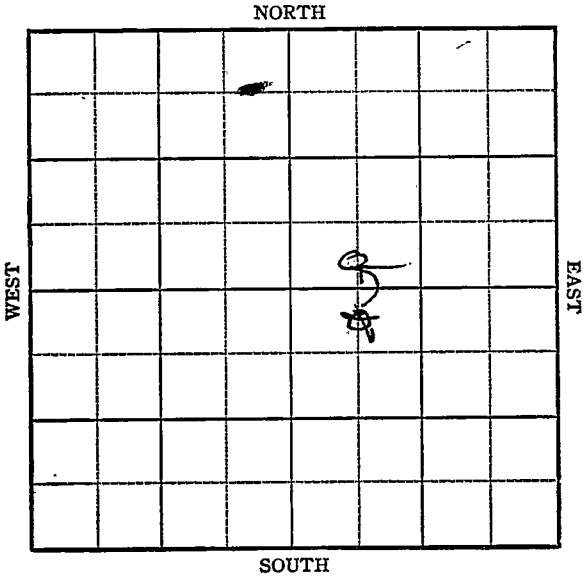

FORM 252-A
5M 10-48 PETROL

KANSAS

Rocks

Sec. 4 Twp. 9 R. 19W

Well No. #6 McClellan Farm

Westgate-Greenland Company

Chandler Pool


~~330'~~ Ft. from N. Line

330' Ft. from S. Line

Ft. from E. Line

660' Ft. from W. Line

C W L NW SE
C S L SW NE

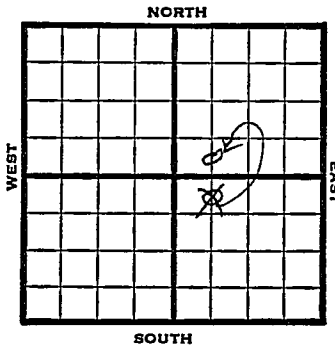

1949	Elev 1981' REPORT
1/19	10" @ 260' Drlg. 790'
1/26	Lansing 3164' Arb. 3409-10' TD 3410' 7"@ 3409'
2/2	"
2/9	"
2/16	TD 3416' 500 acid Swb 18 bbls oil PH 10 hrs.
2/23	"
3/2	"
3/8	"
3/16	"
3/23	"
3/30	"
4/6	TD 3416' Arb. 3409' 7"@ 3409' 500 acid Pump 364 Oil + 5% W Pot 28° Gr. Comp COMPLETED

Form 26 200 Bks. 9-48 Petrol
Kansas

Chandler Pool

Map No. ____ Sec. 4 Twp. 9 R. 19W

Well No. 6 McClellan

Westgate-Greenland Company

FIRST REPORT Contractor

C N L NW SE


330 Ft. from N. Line

____ Ft. from S. Line

____ Ft. from E. Line

660 Ft. from W. Line

SECTION PLAT

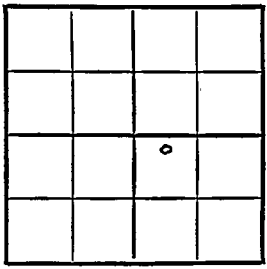

Rooks County

Location ____

Rig up ____

Drilling and Remarks:

10" @ 260

drlg. 790

RECORD

Cased ____ in., ____ ft.

Sand ____

Gas ____

Oil ____

Total Depth ____

PRODUCTION

1st 24 hrs. Nat. ____

1st 24 hrs. after shot ____

Gas ____ Cu. Ft.

Dry Hole ____

Abandoned ____

Date

JAN 19 1949 19 ____

S. J. LEWIS Scout

Form 26 200 Bks. 9-48 Petrol

Chandler Pool

Kansas

Map No. 65 Sec. 4 Twp. 9 R. 19W


Well No. 6 McClellan

Westgate-Greenland Company

CORRECTION Contractor

C S L SW NE

SECTION PLAT

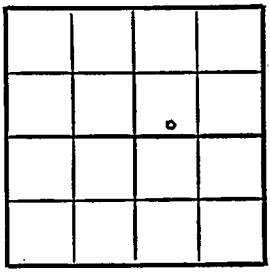

____ Ft. from N. Line

330 Ft. from S. Line

____ Ft. from E. Line

660 Ft. from W. Line

Rooks County

Location

Rig up

Drilling and Remarks:

Reported

C N L, NW SE

RECORD

Cased ____ in., ____ ft.

Sand

Gas

Oil

Total Depth

PRODUCTION

1st 24 hrs. Nat.

1st 24 hrs. after shot

Gas ____ Cu. Ft.

Dry Hole

Abandoned

Date

JAN 26 1949 19

S. I. LEWIS Scout

Form 26 200 Bks. 9-48 Petrol

Chandler Pool

Kansas

Map No. 65 Sec. 4 Twp. 9 R. 19W

Well No. 6 McClellan

Westgate-Greenland Company


COMPLETE

Contractor

C S L SW NE

E 1/1587

SECTION PLAT

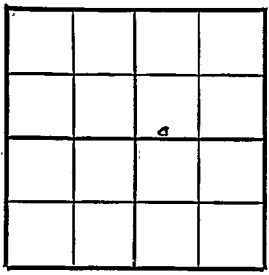

Ft. from N. Line

330 Ft. from S. Line

Ft. from E. Line

660 Ft. from W. Line

Rooks County

Location

Rig up

Drilling and Remarks:

Cir @ 3405
7" @ 3405
500 Acid
Pump 36 Oil +
5 BW Bal +
25 Sx

RECORD

Cased in., ft.

Sand

Gas

Oil

Total Depth 3416

PRODUCTION

1st 24 hrs. Nat.

1st 24 hrs. after shot

Gas Cu. Ft.

Dry Hole

Abandoned

Date

APR 6 1949

19

S. J. LEWIS Scout