


Section 4 Township 9 Range 19W

Well No. 1 McClellan "B"

Company Westgate-Greenland

Chandler Pool

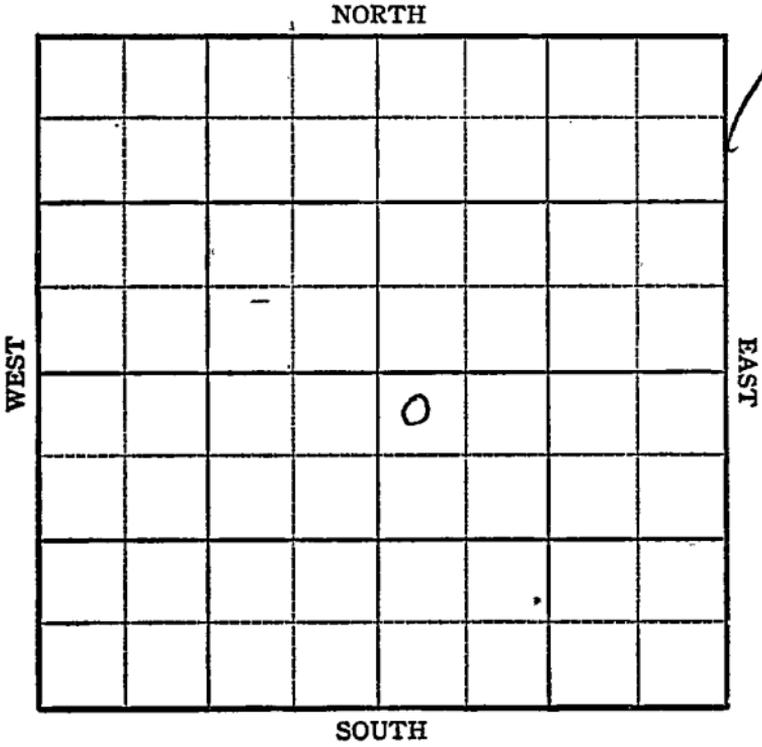

Sec. 4 Twp. 9 R. 19-W ✓

Well No. #1 McClellan "B" Farm

Westgate-Greenland Company


Chandler Pool

330 Ft. from N. Line

_____ Ft. from S. Line

_____ Ft. from E. Line

330 Ft. from W. Line

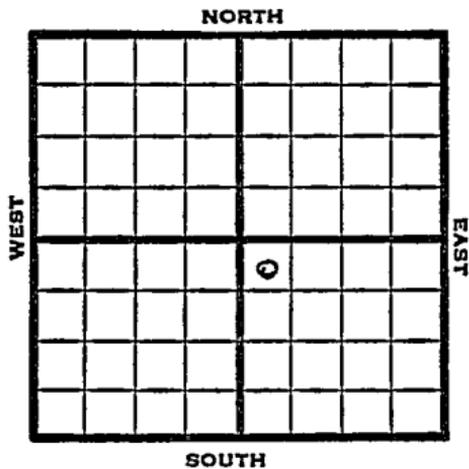

NW SE

1948 Elev. 1980' REPORT

10/6	Location
10/13	"
10/19	RUR
10/26	10" @ 190' Drlg 2335'
11/3	Lansing 3164' Arbuckle 3406' TD 3410'
11/10	5" @ 3408'
11/16	TD 3413' 500 acid swb 10 bbls oil PH
11/23	"
11/30	"
12/8	Arb 3406'
12/15	5" @ 3408'
12/22	Arb 3406' 5" @ 3408' 500 acid Pump 273 oil & 2% W Pot. Gr. 29° TD 3413'

COMPLETED

Map No. _____ Sec. 4 Twp. 9 R. 19WWell No. 1 McClellan "B"Westgate-Greenland Company

FIRST REPORT

Contractor _____

NW SE

SECTION PLAT

		o	

330 Ft. from N. Line

_____ Ft. from S. Line

_____ Ft. from E. Line

330 Ft. from W. Line

Rooks County

Location X

Rig up _____

Drilling and Remarks:

RECORD

Cased _____ in., _____ ft.

Sand _____

Gas _____

Oil _____

Total Depth _____

PRODUCTION

1st 24 hrs. Nat. _____

1st 24 hrs. after shot _____

Gas _____ Cu. Ft.

Dry Hole _____

Abandoned _____

Date

OCT 6 1948 19 _____ S. J. LEWIS Scout

Map No. 65 Sec. 4 Twp. 9 R. 19W

Well No. 1 McClellan "B"

Westgate-Greenland Company

COMPLETE

Contractor

NW SE

E1190
SECTION PLAT

330 Ft. from N. Line

_____ Ft. from S. Line

_____ Ft. from E. Line

330 Ft. from W. Line

		0	

Rooks County

Location _____

Rig up _____

Drilling and Remarks:

Cor 8406

5' @ 3407

500 cu ft

Progr 2300 ft + 2 1/2

Pat

29 2/3

RECORD

Cased _____ in., _____ ft.

Sand _____

Gas _____

Oil

Total Depth *29413*

PRODUCTION

1st 24 hrs. Nat. _____

1st 24 hrs. after shot _____

Gas _____ Cu. Ft.

Dry Hole _____

Abandoned _____

Date

DEC 22 1948

19

S. J. LEWIS

Scout