FORM 51 10M 2-49 PETROL

KANSAS

Rooks


Section 4 Township 9 Range 19W

Well No. 2 McClellan "B"

Company Westgate-Greenland

Chandler

10

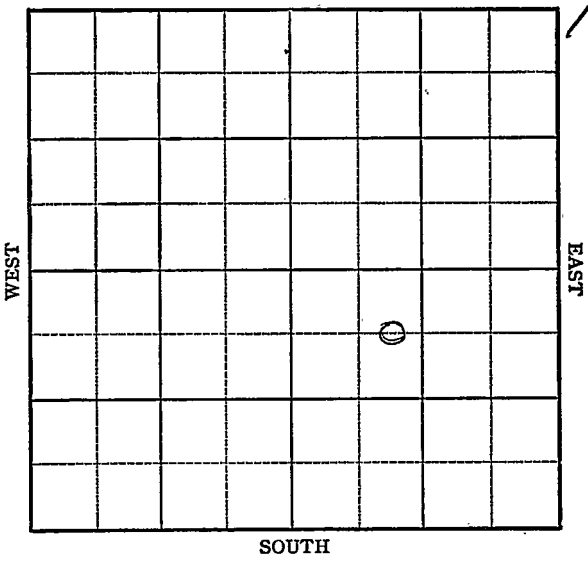

FORM 252-A
5M 10-48 PETROL

KANSAS Rooks

Sec. 4 Twp. 9 R. 19W

Well No. #2 McClellan "B" Farm

Westgate-Greenland Company

Chandler Pool

~~330~~ 1660 Ft. from N. Line


_____ Ft. from S. Line

_____ Ft. from E. Line

~~660~~ 990 Ft. from W. Line

~~C N E~~ NW SE

CWL NWSE

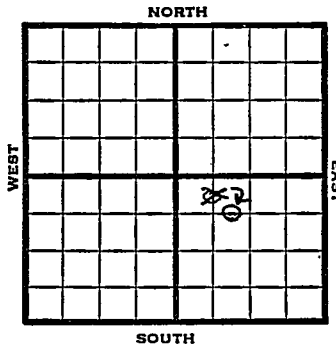

1949	Elev 2013' REPORT
2/23	8" @ 258'
	Drlg. 1175'
3/2	Lansing 3200'
	Drlg 3290'
3/8	Arb. 3438-40
	TD 3440'
	5"@ 3438'
3/16	TD 3441-
	500 acid
	Pump 21 bbls oil PH
3/23	"
3/30	"
4/6	"
4/13	TD 3441'
	Arb. 3438'
	5"@ 3438'
	500 acid
	Pump 271 Oil + 30% W Pot
	28° Gr.
	Comp
	COMPLETED

Form 26 200 Bks. 9-48 Petrol

Chandler Pool

Kansas

Map No. _____ Sec. 4 Twp. 9 R. 19W

Well No. 2 McClellan "B"

Westgate-Greenland Company

FIRST REPORT Contractor

C N L NW SE


330 Ft. from N. Line

_____ Ft. from S. Line

_____ Ft. from E. Line

660 Ft. from W. Line

SECTION PLAT

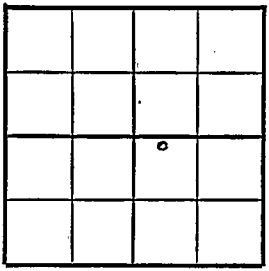

Rooks County

Location _____

Rig up _____

Drilling and Remarks:

8" @ 258

drlg. 1175

RECORD

Cased _____ in., _____ ft.

Sand _____

Gas _____

Oil _____

Total Depth _____

PRODUCTION

1st 24 hrs. Nat. _____

1st 24 hrs. after shot _____

Gas _____ Cu. Ft.

Dry Hole _____

Abandoned _____

Date

FEB 23 1949 19 S. I. LEWIS Scout

Form 26 200 Bks. 9-48 Petrol

Kansas

Chandler Pool

Map No. _____ Sec. 4 Twp. 9 R. 19W

Well No. 2 McClellan "B"

Westgate-Greenland Company

CORRECTION Contractor

C W L NW SE

660 Ft. from N. Line


_____ Ft. from S. Line

_____ Ft. from E. Line

990 Ft. from W. Line

Rooks County

SECTION PLAT

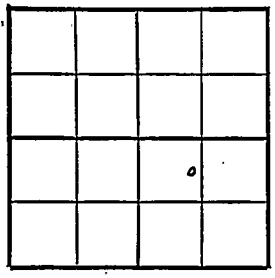

Location _____

Rig up _____

Drilling and Remarks:

Reported

C N L NW SE

RECORD

Cased _____ in., _____ ft.

Sand _____

Gas _____

Oil _____

Total Depth _____

PRODUCTION

1st 24 hrs. Nat. _____

1st 24 hrs. after shot _____

Gas _____ Cu. Ft.

Dry Hole _____

Abandoned _____

Date

MAR 2 1949 19

S. J. LEWIS Scout

Form 26 200 Bks. 9-48 Petrol

Kansas

Chandler Pool

Map No. 65 Sec. 4 Twp. 9 R. 19W

Well No. 2 McClellan "B"


Westgate-Greenland Company

COMPLETE Contractor

C E L NW SE

E12013

SECTION PLAT

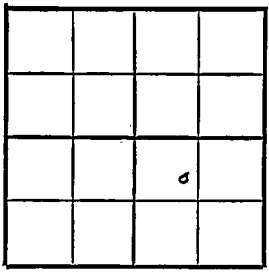

660 Ft. from N. Line

Ft. from S. Line

Ft. from E. Line

990 Ft. from W. Line

Rooks County

Location

Rig up

Drilling and Remarks:

Cir 3438'

5" Csg 3438'

500 gal

Pump 27 bbl + 30%

WOC

28 Sx

RECORD

Cased in., ft.

Sand

Gas

Oil

Total Depth 3441

PRODUCTION

1st 24 hrs. Nat.

1st 24 hrs. after shot

Gas Cu. Ft.

Dry Hole

Abandoned

Date

APR 13 1949 19

S. I. LEWIS Scout