
FORM 51 10M 2-49 PETROL KANSAS Rooks

Section 4 Township 9 Range 19W

Well No. 3 McClellan "B"

Company Westgate-Greenland 9

Chandler

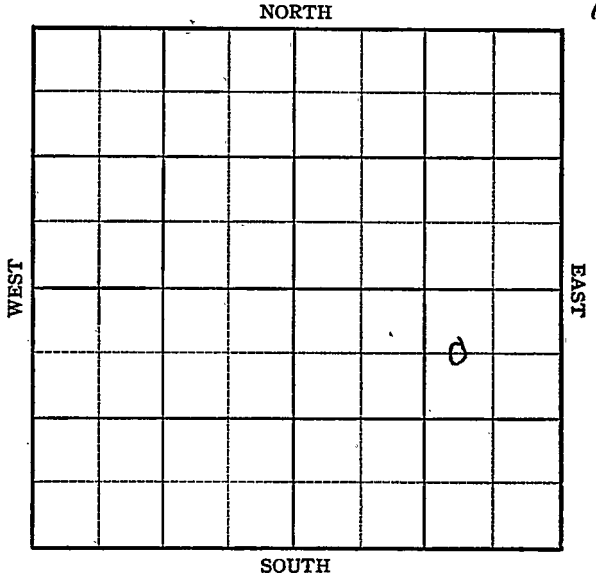

FORM 252-A
5M 10-48 PETROL

KANSAS

Rooks

Sec. 4 Twp. 9 R. 19W ✓

Well No. #3 McClellan "B" Farm

Westgate-Greenland Company

Chandler Pool


660' Ft. from N. Line

Ft. from S. Line

990' Ft. from E. Line

Ft. from W. Line

C W L NE SE

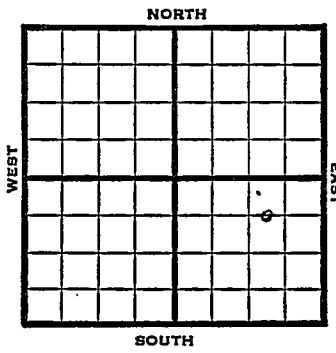

2018'
Elev 2016'

1949	REPORT
3/9	Location
3/16	8"@ 230' Drlg 2440'
3/23	Lansing 3205' Arbuckle 3450' TD 3454' 5" @ 3452'
3/30	TD 3458' SO 500 acid
4/6	TD 3467'
4/12	TD 3467' 44 shots 3202-15 12 shots 3356-60'
4/20	"
4/27	"
5/4	TD 3467' Lans. 3205' Arb. 3450' 5"@ 3452' Perf Lans. wtr. Aband.

ABANDONED

Form 26 200 Bks. 9-48 Petrol

Kansas

Chandler Pool

Map No. _____ Sec. 4 Twp. 9 R. 19W

Well No. 3 McClellan "B"

Westgate-Greenland Company

FIRST REPORT Contractor

C W L NE SE


660 Ft. from N. Line

_____ Ft. from S. Line

990 Ft. from E. Line

_____ Ft. from W. Line

SECTION PLAT

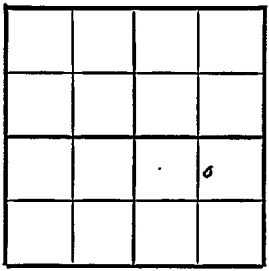

Rooks County

Location X

Rig up _____

Drilling and Remarks:

RECORD

Cased _____ in., _____ ft.

Sand _____

Gas _____

Oil _____

Total Depth _____

PRODUCTION

1st 24 hrs. Nat. _____

1st 24 hrs. after shot _____

Gas _____ Cu. Ft.

Dry Hole _____

Abandoned _____

Date

MAR 9 1949 19 S. J. LEWIS Scout

Form 26 200 Bks. 9-48 Petrol

Kansas

Chandler Pool

Map No. K-65 Sec. 4 Twp. 9 R. 19W

Well No. 3 McClellan "B"

Westgate-Greenland Company


ABANDONED

Contractor

C W L NE SE

El. 2018'

SECTION PLAT

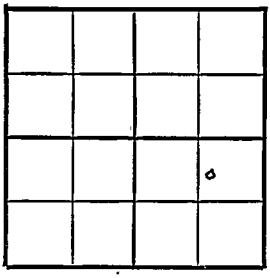

660 Ft. from N. Line

Ft. from S. Line

990 Ft. from E. Line

Ft. from W. Line

Rooks County

Location

Rig up

Drilling and Remarks:

Lime 3205

RTD 3458

5½" @ 3452

Perfs Lime Water

RECORD

Cased in., ft.

Sand

Gas

Oil

Total Depth 3467

PRODUCTION

1st 24 hrs. Nat.

1st 24 hrs. after shot

Gas Cu. Ft.

Dry Hole

Abandoned

Date

MAY 4 1949 19

S. J. LEWIS Scout