

KANSAS



Rooks

Section 4 Township 9 Range 19W

Well No. 1 McGlellan "C"

Company Westgate-Greenland

NORTH Webster

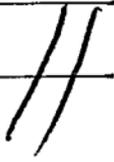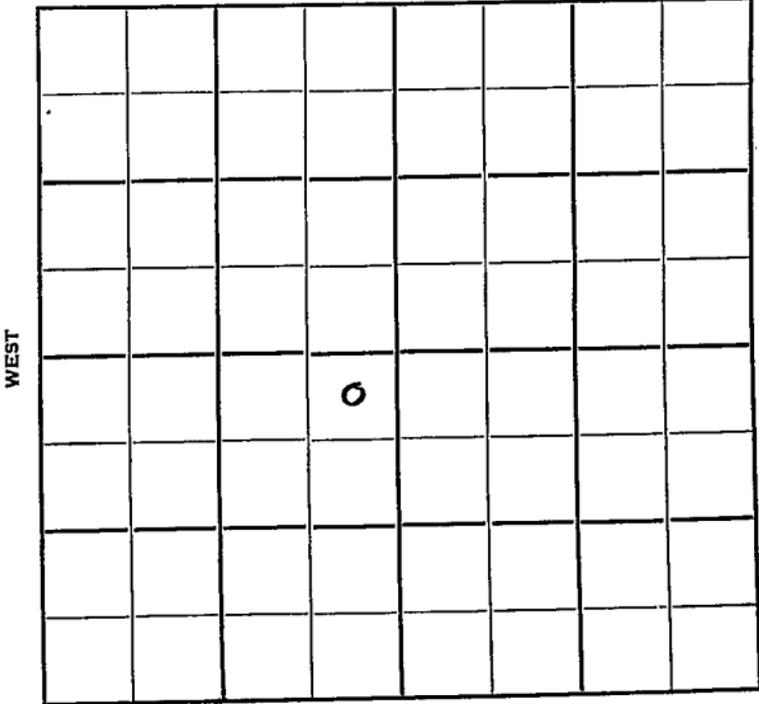

Sec. 4 Twp. 9 R. 19W

Well No. #1 McClellan "C" Farm

Westgate-Greenland Company

Webster Pool (Jackson, Cont.)


NORTH

330' Ft. from N. Line

_____ Ft. from S. Line

330' Ft. from E. Line

_____ Ft. from W. Line

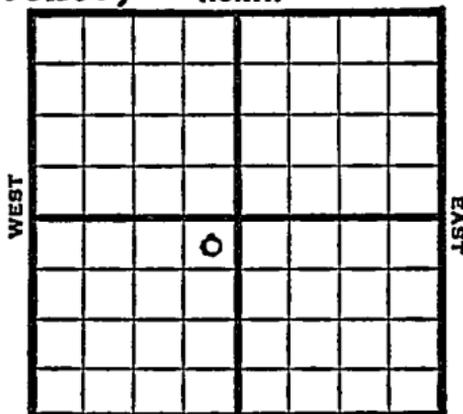

NE SW

1949 Elev 1997' REPORT

6/29	10" @ 151' Drlg. 250'
7/6	Lansing 3184' Drlg. 3300'
7/12	"
7/20	TD 3447' 500 acid Swb 3 bbls oil PH 12 hrs.
7/27	"
8/3	"
8/10	"
8/17	TD 3447' Arb. 3424' 5" @ 3425' Pump 4l Oil / 14% W Pot 27° Gr. Comp COMPLETED

Map No. _____ Sec. 4 Twp. 9 R. 19W

Well No. 1 McClellan "C"

Westgate-Greenland Company

Jackson Contractor

NE SW

FISSION REPORT

330 Ft. from N. Line

_____ Ft. from S. Line

330 Ft. from E. Line

_____ Ft. from W. Line

Rooks County

Location _____

Rig up _____

Drilling and Remarks:

10" @ 151

drlg. 250

RECORD

Cased _____ in., _____ ft.

Sand _____

Gas _____

Oil _____

Total Depth _____

PRODUCTION

1st 24 hrs. Nat. _____

1st 24 hrs. after shot _____

Gas _____ Cu. Ft.

Dry Hole _____

Abandoned _____

Date

JUN 29 1949

S. J. LEWIS

Scout

Kansas

Map No. K65 Sec. 4 Twp. 9 R. 19WWell No. 1 McClellan "C"Westrate-Greenland Company**COMPLETE**

Contractor


NE SW

E. 1. 1997
SECTION PLAT330 Ft. from N. Line

_____ Ft. from S. Line

330 Ft. from E. Line

_____ Ft. from W. Line

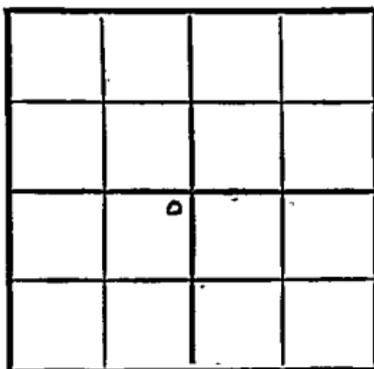

Rooks County

Location _____

Rig up _____

Drilling and Remarks:

Cr 83424
5" @ 3425.Pump 4/1 oil + 14%
W.P.S.27 = 8/2**RECORD**

Cased _____ in., _____ ft.

Sand _____

Gas _____

Oil _____

Total Depth 3447**PRODUCTION**

1st 24 hrs. Nat. _____

1st 24 hrs. after shot _____

Gas _____ Cu. Ft.

Dry Hole _____

Abandoned _____

Date

AUG 17 1949

19

S. J. LEWIS Scout