

Section 4 Township 9 Range 20WWell No. #1 H. M. WhismanCompany Sinclair

								15
				0				

NORTH

WEST

EAST

SOUTH

Sec. 4 Twp. 9 R. 20W

Well No. #1 H. M. Whisman Farm

Sinclair Company

D & M Contractor

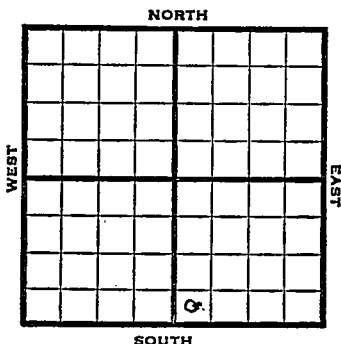
Wildcat

 Ft. from N. Line

330 Ft. from S. Line

 Ft. from E. Line

330 Ft. from W. Line



SW SW SE

Amerada-DHM

1952 Elev. 2150' REPORT

8/13 MI

8/20 Drlg. 1000'

8/27 Drlg. 3150'

9/4 Spud 8-17-52

D&A TD 3838' 9" @ 219'

Top. 3152 Heeb. 3357

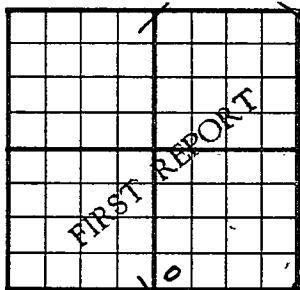
Br. Li 3380 Lans. 3398

DST 3554-60 open 1 hr. rec. 23'

mud Cong. 3698 Arb. 3815

TD 3838' D&A

ABANDONED

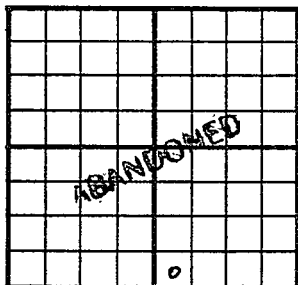
County **Rooks** State **Kansas**Sec. **4** (Blk.) **9** (Sur.) **20N** Map No.Operator **Sinclair**Well No. **1** Farm **H. E. Whisman**Elev. Location **SW SW SE****330** Ft. From **S** Line **SE****330** Ft. From **T** Line Quarter1st. Report **AUG 13 1952**

Completion

Remarks **Merada-DHW****D & H-Contr.**

Spudding Date

Drlg. Data **Wildcat****MI****J. G. McGEHEE**

County _____ Rocks _____ State KansasSec. 4 (Blk. Twp.) 9 (Sur. Rge.) 20W Map No. _____Operator SinclairWell No. 1 Farm H. M. WhismanElev. 2150 Location SW SW SE330Ft. From S Line SE330Ft. From W Line Quarter1st. ReportCompletion SEP 4 1952Remarks WildcatD & M Drlg. - Contr.Spudding Date 8-17-52Drlg. Data D & A TD 38389" @ 219 Top. 3152 Heeb. 3357Br. lime 3380 Lans. 3398 DST 3554-60open 1 hr. Rec. 23' mud Cong. 3698Arb. 3815 TD 3838D & A