

Section 4 Township 9 Range 21W

Well No. #1 Napue

Company Barnett Oil et al

Wildcat

NORTH

|  |  |  |   |  |  |  |  |
|--|--|--|---|--|--|--|--|
|  |  |  |   |  |  |  |  |
|  |  |  |   |  |  |  |  |
|  |  |  |   |  |  |  |  |
|  |  |  |   |  |  |  |  |
|  |  |  | 0 |  |  |  |  |
|  |  |  |   |  |  |  |  |
|  |  |  |   |  |  |  |  |
|  |  |  |   |  |  |  |  |

WEST

EAST

SOUTH

Graham

KANSAS ✓

Sec. 4 Twp. 9 R. 21W

Well No. #1 Napue Farm

Barnett Oil et al Company

Wildcat (Peel, Contr.)


330' Ft. from N. Line

\_\_\_\_\_ Ft. from S. Line

330' Ft. from E. Line

\_\_\_\_\_ Ft. from W. Line

NE SW

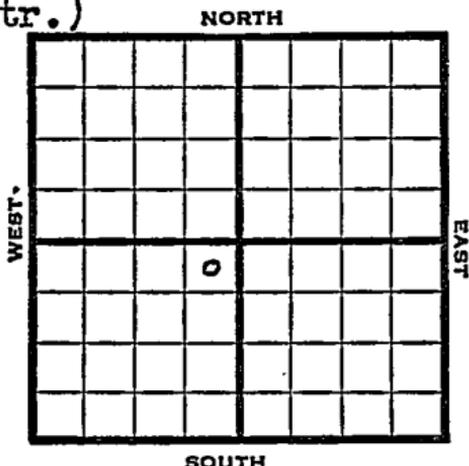

1949

Elev. 2172' REPORT

12/14

RUR

12/28

Lans. 3366'

BKC 3586'

Arb. 3726'

TD 3728'

**ABANDONED**

$$\begin{array}{r}
 3726 \\
 2172 \\
 \hline
 1554 \\
 \hline
 \end{array}$$

Map No. \_\_\_\_\_ Sec. 4 Twp. 9 R. 21W

Well No. 1 Napue

Barnett Oil etal. Company

Peel Contractor

NE SW


FIRST REPORT  
SECTION PLAT

330 Ft. from N. Line

\_\_\_\_\_ Ft. from S. Line

330 Ft. from E. Line

\_\_\_\_\_ Ft. from W. Line

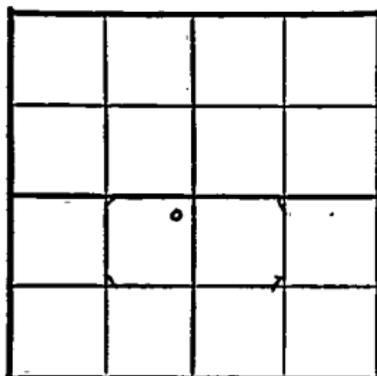

Graham County.

Location \_\_\_\_\_

Rig up \_\_\_\_\_

Drilling and Remarks:

R U R

RECORD

Cased \_\_\_\_\_ in., \_\_\_\_\_ ft.

Sand \_\_\_\_\_

Gas \_\_\_\_\_

Oil \_\_\_\_\_

Total Depth \_\_\_\_\_

PRODUCTION

1st 24 hrs. Nat. \_\_\_\_\_

1st 24 hrs. after shot \_\_\_\_\_

Gas \_\_\_\_\_ Cu. Ft.

Dry Hole \_\_\_\_\_

Abandoned \_\_\_\_\_

Date

DEC 14 1949 19

S. J. LEWIS Scout

Kansas

Map No. \_\_\_\_\_ Sec. 4 Twp. 9 R. 21WWell No. 1 Napue

Barnett Oil etal. \_\_\_\_\_ Company

ABANDONED

Contractor

NE SW

E 12172  
SECTION PLAT330 Ft. from N. Line

\_\_\_\_\_ Ft. from S. Line

330 Ft. from E. Line

\_\_\_\_\_ Ft. from W. Line

|  |   |  |  |
|--|---|--|--|
|  |   |  |  |
|  |   |  |  |
|  | o |  |  |
|  |   |  |  |

Graham County

Location \_\_\_\_\_

Rig up \_\_\_\_\_

Drilling and Remarks:

Lease 3366  
BKC 3586  
Per 3726

## RECORD

Cased \_\_\_\_\_ in., \_\_\_\_\_ ft.

Sand \_\_\_\_\_

Gas \_\_\_\_\_

Oil \_\_\_\_\_

Total Depth 3725

## PRODUCTION

1st 24 hrs. Nat. \_\_\_\_\_

1st 24 hrs. after shot \_\_\_\_\_

Gas \_\_\_\_\_ Cu. Ft.

Dry Hole \_\_\_\_\_

Abandoned \_\_\_\_\_

Date

DEC 28 1949 19

S. J. LEWIS

Scout