

Graham

KANSAS


SECTION 4 TOWNSHIP 9 RANGE 23W

WELL NO. #3 McPherson

COMPANY Imperial Oil

7

NORTH

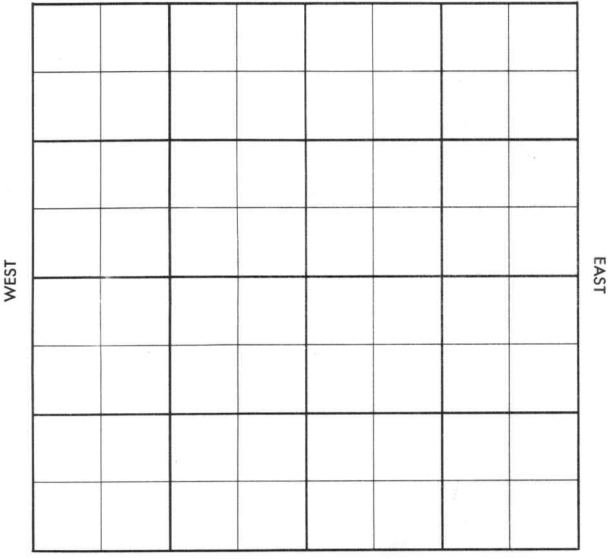

SOUTH

Graham

KANSAS

SEC. 4	TWP. 9	R. 23W
-----------	-----------	-----------

WELL NO.

#3 McPherson

FARM

COMPANY

Imperial Oil

CONTRACTOR

Harms-Burt

Brush Creek


_____ Ft. from N. Line

_____ Ft. from S. Line

_____ Ft. from E. Line

_____ Ft. from W. Line

C SW NE

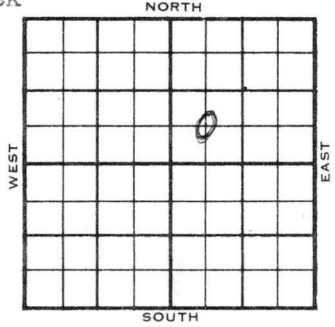

3/8 mile SDX

1956	ELEVATION	REPORT
	2252	
4-11	Comm. 4-7-56 8" @ 203 Drlg. 2385	
4-19	Lans. 3580 DST 3704-24, op 1 hr. rec. 960' wtr., 700/20" DST 3736-62, op 1 hr. rec. 1860' gas, 275' oil, 840# TD 3764 5 1/2" @ 3764	
4-26	Moving in cable tools	
5-3	BD 3771, FU 1800' SW, PB 3755, 18/ 3747-50, 1500 A, S/ 2 boph, 9 hrs. POP	
5-10	No report	
5-17	"	
5-24	"	
5-31	P/ 36 bopd, no/wtr. Anh. 1895' TD 3764'	

COMPLETED

County Graham Elev. _____
 Sec. 4 Twp. 9 Rge. 23W
 Company Imperial Oil
 Farm Name McPherson No. 3

TOPS	DEPTH	LOG	DATUM	Loc. in Sec.
Anh.	1895			C SW NE
TP.				
H.				
Tr.				
Dg.				
Bl.				
L.				Geol. _____
K.C.				Contr. _____
B.K.C.				Harms-Burt
Ce.				
C.				
M.				Pool
M.				Brush Creek
K.				
Mz.				
Ma.				
V.				
S.				
S.				
A.				
R.				
Pe.				
G.				
T.D.				

FIRST REPORT
 APR 11 '56
 3/8 mi.

Date Comm. 4-7-56
8" @ 203 drlg. 2385

APR 11 1956

R.G.

[Handwritten signature]

Co.

Lse.

No.

Sec.

T.

R.

Co.

Lse.

No.

Sec.

T.

R.

County Graves Elev. 2252
 Sec. 4 Twp. 9 Rgs. 23W
 Company Imperial Oil
 Farm Name McPherson No. 3

TOPS	DEPTH	LOG	DATUM	Loc. in Sec.
Anh.	1395			C SW 1/4
TP.				
H.				
Tr.				
Dg.				
Bl.				
L.	3580		1328	Geol.
K.C.				Contr.
B.K.C.				Horns-Burt
Ce.				
C.				Pool
M.				Brush Creek
M.				
K.				
Mz.				
Me.				
V.				
S.				
S.				
A.				
R.				
PE.				
G.				
TD.	3764			

COMPLETE

Date Comm. 4-7-56 MAY 29 1956

8" @ 203' dril. 2305 APR 18 '56 DST 3704
 -24 hrs rec 960' wth BHP 700'
 20" DST 3736-62 hrs rec 1860'
 gas + 275' oil BHP 840
 5 1/2 @ 3764 / APR 25 '56 MICT MAY 2 '56
 Co DD 3771 TD FU 1800' SW
 PB 3755 18/3747-50 1 1/2 \$
 2 Bopd no/w 9 hrs POT MAY 2 '56
 MAY 16 '56 MAY 23 '56 MAY 29 '56 Ph.P. 36 Bopd no/w