


Section 4 Township 9 Range 24W

Well No. 1 Hildebrand

Company N C R A

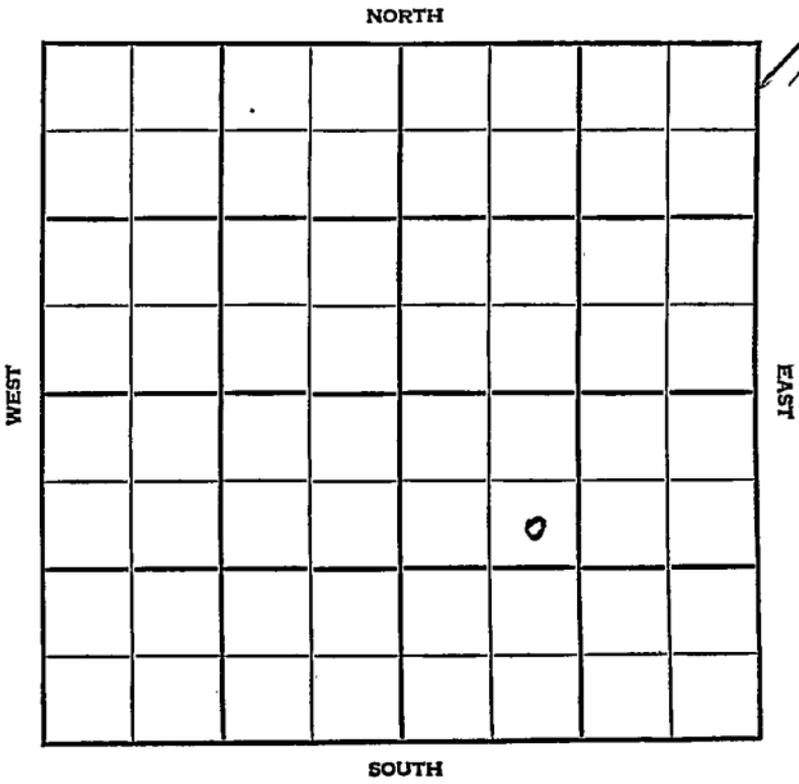

Graham KANSAS

SEC.	TWP.	R.
4	9	24W

WELL NO. 1 Hildebrand FARM

COMPANY N C R A

CONTRACTOR Braden Drlg.


Holly Pool

990 Ft. from N. Line

Ft. from S. Line

Ft. from E. Line

990 Ft. from W. Line

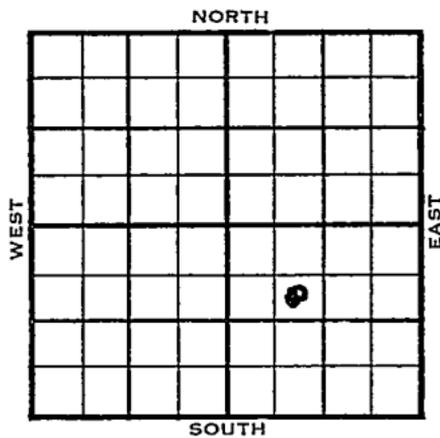

SE NW SE

ELEVATION	REPORT
1955	2454'

3/9 MIR

4/20 Spud 3-7-55
 Oil Well
 TD 4030'
 8" @ 221'
 Anhy 2135', Heeb 3761' Lans 3798'
 DST 3940'-60' opn 1 hr, rec 1060' gas,
 240' oil, 925#
 DST 3968'-82' opn 1 hr, rec 1' Mud
 0# B KC 4025'
 TD 4030'
 5" @ 4029'
 12/ 3955'-58' S/ 1 1/2 boph 4 hr.
 250 A. S/ 48 bo 9 hr. 500 A S/ 52 b
 4 hr.
 Comp 111 bopd.

COMP 111

