

Graham

KANSAS

DX 78-1

Section 4 Township 9 Range 24W

Well No. #3 Keith

Company Champlin Ref.

NORTH

WEST

EAST

					0		

SOUTH

15

HOT FILE - Graham KANSAS

SEC. 4	TWP. 9	R. 24W
--------	--------	--------

WELL NO. 3 Keith FARM

COMPANY

CONTRACTOR Champlin Ref.

Armer


Holley Pool

_____ Ft. from N. Line

330 _____ Ft. from S. Line

_____ Ft. from E. Line

990 _____ Ft. from W. Line

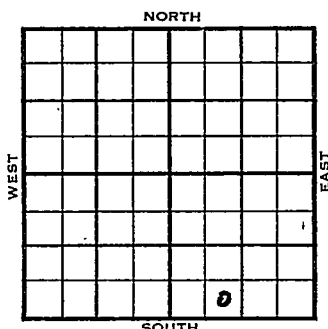

SE SW SE

1955	ELEVATION 2415'	REPORT
------	-----------------	--------

1/19	Spudded 1-15-55 8" @ 215' Drlg. 1560'
3/2	Spud 1-15-55 Oil Well TD 3998' 8" @ 215' Heeb 3711' Lans. 3750' DST 3773'-94' opn 1 hr, rec 40' vsocm 1200# DST 3900'-10' opn 1 hr, rec 1260' gas, 215' oil, 30' vhocm DST 3924'-32' opn 1 hr, rec 4' Mud 90# B KC 3981' DST 3966'-85' opn 1 hr, rec 4' Mud 195# TD 3998' 5" @ 3996' CO 16/ 3906-10 S/ 1 1/4 boph 18 hr. 3000 A S/ 18 1/2 boph 5 hr. P/ 185 bo 16 hr. Comp 243 bopd.

COMPLETED

County Graham State Kansas

Sec. **4** (Blk. Twp.) **9** (Sur. Rge.) **24W** Map No.

Operator **Champlin Ref.**

Well No. **3** * Farm **Keith**

Elev.	2415	Location	SE SW SE
-------	------	----------	----------

FIRST REPORT

330 Ft. From S Line SE c

990 Ft. From ~~W~~ Line Quarter

1st. Report JAN 19 1955

Completion .

Remarks _____


Armer - Contr.

Spudding Date 1-15-55

Drig. Data Holley Pool

8" @ 215 drlg. 1560

FABEN G. L. S. 1947

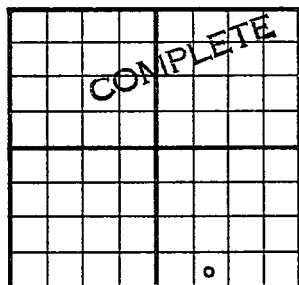County Graham State KansasSec. 4 (Blk.) 9 (Sur.) 24W Map No.Operator Champlin Ref.Well No. 3 Farm KeithElev. 2415 Location SE SWSE330 Ft. From S Line SE990 Ft. From W Line Quarter

1st. Report

Completion MAR 2 1955Remarks Holley PoolArmer - Contr.Spudding Date 1-15-55Drilg. Data Oil well TD 39988" @ 215 Heeb. 3711 Lans. 3750DST 3773-94 open 1 hr. Rec. 40' vsocm1200# DST 3900-10 open 1 hr. Rec.1260' gas 215' oil 30' vhocmDST 3924-32 open 1 hr. Rec. 4' mud90# B KC 3981 DST 3966-85 open 1 hr.Rec. 4' mud 195# TD 3998 5" @ 3996CO 16/ 3906-10 S/ 1½ boph. 18 hr.3000 A S/ 18½ boph 5 hr. P/ 185 bo16 hr. Comp. 243 bopd

FABEN GILSTRAP