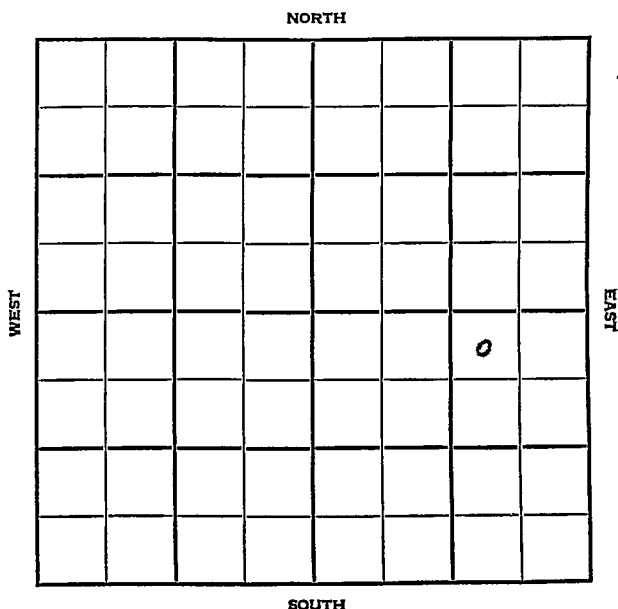


Section 4 Township 9 Range 24WWell No. 6 KeithCompany Champlin Ref.

Graham

KANSAS

SEC.	TWP.	R.
4	9	24W

WELL NO.

#6 Keith

FARM

COMPANY

Champlin Ref.

CONTRACTOR

Armer


Holley Pool

330 Ft. from N. Line

Ft. from S. Line

990 Ft. from E. Line

Ft. from W. Line

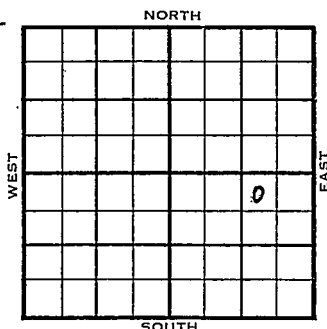

NW NE SE

	ELEVATION	REPORT
1955	2458'	

3/2 Spud 2-28-55
8" @ 198'

4/6 WOC
Spud 2-28-55, Oil Well, TD 4047
8" @ 198 Heeb 3755, Lans 3804,
DST 3954-72 open 1 hr. Rec.
115' HMC0 780# BKC 4032, TD
4047, 5" @ 4042 CO to 3980,
20/3963-68, S/1/2 BOPH 5 hr.
500 A S/41 BO 8 hr
Comp 160 BOPD

COMPLETED


County Graham State Kansas
 Sec. 4 (Blk.) 9 (Sur.) 24W Map No.
 Operator Champlin Ref.
 Well No. 6 Farm Keith
 Elev. Location NW NE SE

330 Ft. From N Line SE
990 Ft. From E Line Quarter
 1st. Report MAR 2 1955
 Completion
 Remarks Armer - Contr.
 Spudding Date 2-28-55

Drlg. Data Holley Pool
8" @ 198 WOC

FABEN GILSTRAP

County Graham State Kansas
 Sec. 4 (Blk. Twp.) 9 (Sur. Rge.) 24W Map No. _____
 Operator Champlin Ref.
 Well No. 6 Farm Keith
 Elev. 2458 Location NW NE SE

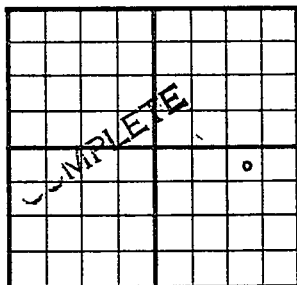

330 Ft. From N Line SE
990 Ft. From E Line Quarter
 1st. Report _____
 Completion APR 6 1955
 Remarks Holley Pool
Armer - Contr.
 Spudding Date 2-28-55

Drlg. Data Oil well TD 4047
8" @ 198 Heeb. 3755 Lans. 3804
DST 3954-72 open 1 hr. Rec. 115' hmco
780# B KC 4032 TD 4047 5" @ 4042
CO to 3980 20/ 3963-68 S/ $\frac{1}{2}$ boph
5 hr. 500 A. S/ 41bo 8 hr.
Comp. 160 bopd

FABEN GILSTRAP