


Section 4 - Township 9 Range 24 W

Well No. #1 George Keith "A"

Company Champlin Ref.

6

NORTH

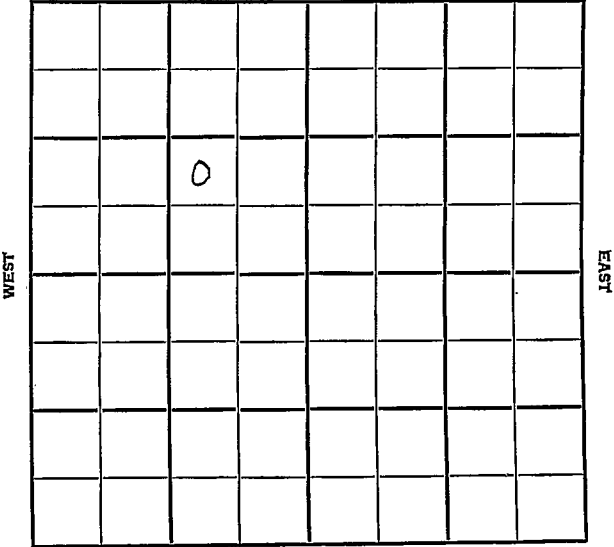

SOUTH

Graham

KANSAS

SEC.

4

TWP.

9

R.

24W

WELL NO.

#4 George Keith "A"

FARM

COMPANY

Champlin Ref.

CONTRACTOR

Wentworth


Holley

Ft. from N. Line

Ft. from S. Line

Ft. from E. Line

Ft. from W. Line

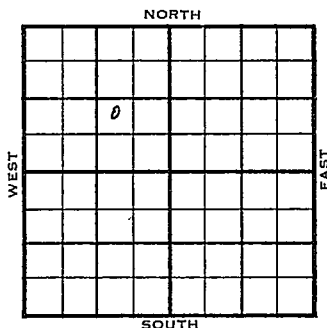

NW SE NW

1955

ELEVATION

2481

REPORT

9/7

Comm 9-3-55

8" @ 215/150

Drlg 2000

10/12

Comm 9-3-55

8" @ 215 w/150

5 1/2" @ 4049 w/150

H 3780

Tr 3804

L 3820

BKC 4042

TD 4055

54/3974-84 Swb 1/2 boph no wtr

3 hrs 500 Acid ~~to~~ Swb 11 boph no

wtr 7 hrs POP Ph P 199 bopd no wtr

COMPLETED


TOPS

DEPTH

LOG

DATUM

Loc. in Sec. _____

Anh.

Tp.

H.

Tr.

Dg.

Bl.

L.

K.C.

B.K.C.

Ce.

C.

M.

M.

K.

Mz.

Me.

V.

S.

S.

A.

R.

Pe.

G.

G.

T.D.

N.W. S.E. N.W.

Geol. _____

Contr. _____

Wentworth

Pool _____

Holley

FIRST REPORT
SEP 7 1955Date Comm. 9-3-55

8" @ 215/150 dslg. 2000

Co.

Lse.

No.

Sec.

T.

R.

County Granham Elev. 2481
 Sec. 4 Twp. 9 Rge. 24W
 Company Champlin Ref.
 Farm Name George Keith "A" No. 4

TOPS	DEPTH	LOG	DATUM
Anh.			
TP.			
H.	3780		1299
Tr.	3804		1323
Dg.			
BL.			
L.	3820		1339
K.C.			
B.K.C.	4042		1561
Ce.			
C.			
M.			
M.			
K.			
Mz.			
Me.			
V.			
S.			
S.			
A.			
R.			
PE.			
G.			
T.D.	4055		

Loc. in Sec.

NW SE NW


Geol.

Contr.

Wentworth

Pool

Holley

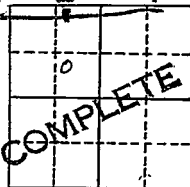Date Comm. 9/3/55 OCT 1 2 1955

8" 215 w/150 5 1/2" 4049 w/150 5 1/4/3974-84

Swb 1/2 boph no wtr 3 hrs. 500 Acid Swb

11 boph no wtr 7 hrs. POP

Ph P 199 bopd no wtr