


Section 4 Township 9 Range 24 W

Well No. #3 Keith "A"

Company Champlin Ref.

5

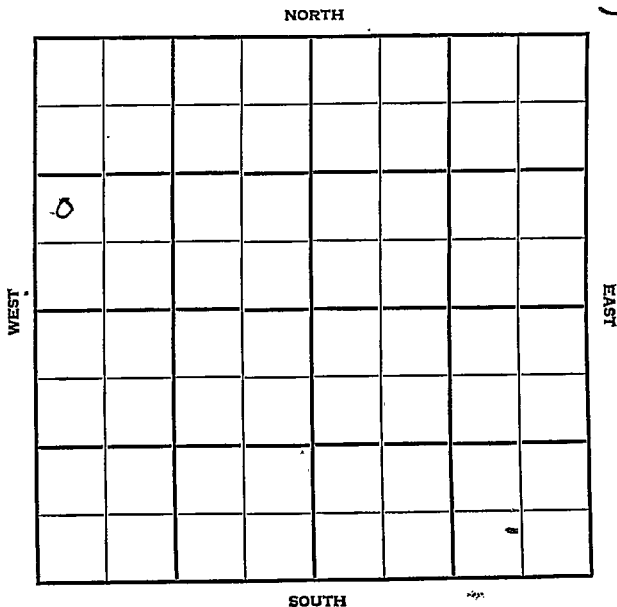

Graham

KANSAS

SEC. -4	TWP. 9	R. 21W
------------	-----------	-----------

WELL NO.

#3 Keith "A"

FARM

COMPANY

Champlin Ref.

CONTRACTOR

Holly


_____ Ft. from N. Line

_____ Ft. from S. Line

_____ Ft. from E. Line

_____ Ft. from W. Line

NW SW NW

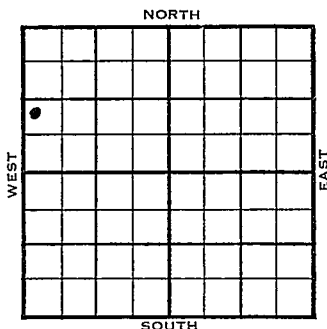

1955

ELEVATION

REPORT
FIRST REPORT

8/10

Location

9/28

Comm 8-11-55

8 5/8" @ 198/150

5 1/2" @ 5061/150

H 3785

Tr 3808

L 3823

BKG 4047

TD 4055

~~8 5/8" @ 198/150~~

CO 42/3979-86 S/1 1/2 boph 4 hr 500 A

S/10 boph 6 hr Comp 125 bopd

COMPLETED

County Graham Elev. 2486
 Sec. 11 Twp. 9 Rge. 24W
 Company Champlin Ref.
 Farm Name Keith "A" No. 3

TOPS	DEPTH	LOG	DATUM
------	-------	-----	-------

Loc. in Sec. NW SW NW

Anh.			
TP.			
H.	<u>3785</u>		<u>1299</u>
Tr.	<u>3108</u>		<u>1323</u>
Dg.			
BL.			
L.	<u>3823</u>		<u>1337</u>
K.C.			
B.K.C.	<u>4047</u>		<u>1561</u>
Ce.			
C.			
M.			
M.			
K.			
Mz.			
Mq.			
V.			
S.			
S.			
A.			
R.			
PE.			
G.			
T.D.	<u>4055</u>		

Geol.

Contr.

Pool

Holly

COMPLETE

Date Comm. 8-11-55 SEP-28 1955
8 5/8" @ 198/150 5 1/2" @ 5061/150 C^o

12/ 3979-86 S/ 1 1/2 boph 4 hr. 500 A
S/ 10 boph 6 hr. Comp. 125 bopd