


Graham

KANSAS

SECTION 4 TOWNSHIP 9 RANGE 24W

WELL NO. #1 Keith "E"

COMPANY H.G. Kaiser

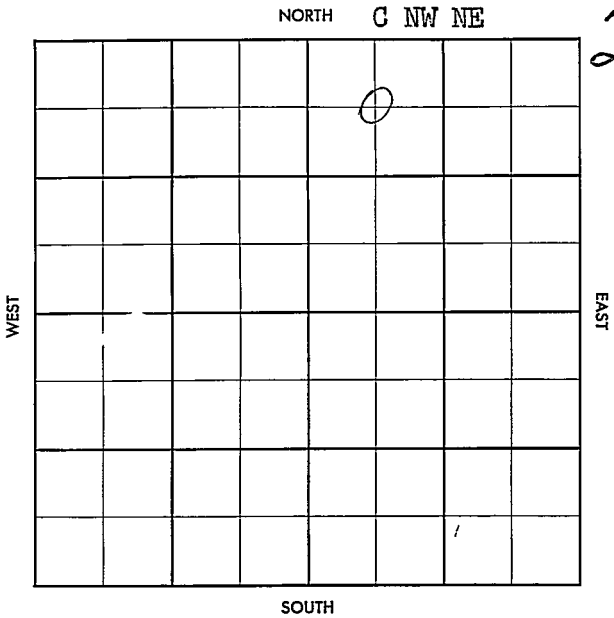

County Granham Elev. \_\_\_\_\_  
 Sec. 4 Twp. 9 Rgs. 24W  
 Company H. G. Kaiser  
 Farm Name Keith "E" No. 1

TOPS	DEPTH	LOG	DATUM
Anh.			
Tp.			
H.			
Tr.			
Dg.			
Bl.			
L.			
K.C.			
B.K.C.			
Ce.			
C.			
M.			
M.			
K.			
Mz.			
Me.			
V.			
S.			
S.			
A			
R.			
Pe.			
G.			
T.D.			

Loc. in Sec. C NW NE

Geol. \_\_\_\_\_

Contr. Armer Tools

Pool

Holley

FIRST REPORT

Date Comm. Champlin (FO)

W O R T

S

Co.  
 Sec.  
 No.  
 No.  
 Sec.  
 T.  
 R.

County Graham Elev. 2454  
 Sec. 4 Twp. 9 Rgs. 24W  
 Company H. G. Kaiser  
 Farm Name Keith "E" No. 1

TOPS	DEPTH	LOG	DATUM	Loc. in Sec.
Anh.	2146			C NW NE
Ip.				
H.	3756			
Tr.	3779			
Dg.				
Bl.				
L.	3795			Geol.
K.C.				Contr.
B.K.C.	4022			
Ce.				Armer Tools
C.				Pool
M.				Holley
M.				
K.				
Mz.				
Me.				
V.				
S.				
S.				
A.				
R.				
PE.				
G.				
TD.	4055			COMPLETE MAY 1 '57

Date Comm. Champlin (FO)

W O R T MAR 27 '57 APR 3 '57 APR 10 '57 4-1-57  
 878 193/150 @ 3758 APR 17 '57  
 DST 3838-55 1 hr see 10' Md  
 All press o DST 3934-61 gas  
 1 hr see 45' Md + 550 BHP  
 110/15" 5 1/2 @ 4054 / APR 24 '57 MICT  
 co 16/ 3950-54 co gal Acid  
 @ 1 Gal oil / 1/4 / 3 @ 5.85  
 Bopd + 4/10 gal wth 6 hrs POT  
 MAY 1 '57 P. 144 Bopd 110/15 wth.