

Graham


KANSAS

SECTION 4 TOWNSHIP 9 RANGE 23W

WELL NO. #1 Quint

COMPANY Imperial Drlg.

NORTH

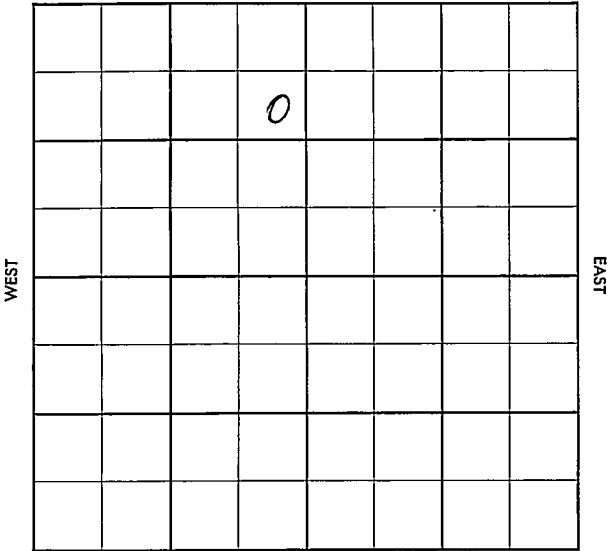

SOUTH

Graham

KANSAS

SEC.	TWP.	R.
4	9	23W

WELL NO.

#1 Quint

FARM

COMPANY

Imperial Drlg.

CONTRACTOR

Harms-Burt


Brush Creek

Ft. from N. Line

Ft. from S. Line

Ft. from E. Line

Ft. from W. Line

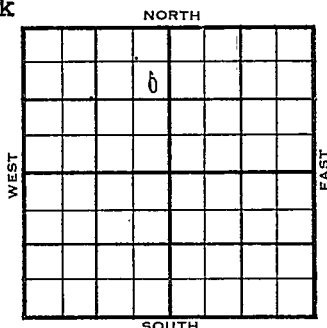SE NE ~~SW~~ NWSDX - $\frac{3}{4}$ mile

1956

ELEVATION

~~###~~ 2249'

REPORT

5-2

Comm. 4-26-56
8" @ 200 w/200
Drlg. 3275

5-9

DST 3707-35 op 30 min. rec. 30' mud,
800/20"
DST 3734-70 op 30 min. rec. 4' mud,
BHP 0/20"
D&A
H. 3548, Tr. 3571', L. 3588',
TD 3815'

ABANDONED

County	Graham	Elev.	
Sec.	11	Twp.	9
Company	Imperial Drlg.	Rge.	23W
Farm Name	Quint	No.	1

TOPS	DEPTH	LOG	DATUM	Loc. in Sec.
Anh.				SE NE NW
Tp.				
H.				
Tr.				
Dg.				
Bl.				
L.				
K.C.				Geol.
B.K.C.				Contr.
Ce.				Harms-Burt
C.				
M.				Pool
M.				Brush Creek
K.				
Mz.				
Mo.				
V.				
S.				
S.				
A				
R.				
Pe.				
G.				
T.D.			SDA-	

	0	
FIRST	REPORT	
DAY 2-55		
1/10/55		

Date Comm. 4-26-56
 8" @ 200/200 drlg. 3275

APR 2 1955

APR 2 1955

