

Section 5 Township 9 Range 15WWell No. 1 BeisnerCompany Anderson-Prichard

NORTH

				0			

WEST

EAST

SOUTH


 Sec. 5 Twp. 9 R. 15W

 Well No. #1 Beisner Farm

Anderson-Prichard Company

Glenn Peel Contractor


Wildcat
990 Ft. from N. Line

Ft. from S. Line

Ft. from E. Line

330 Ft. from W. Line

SW NW NE

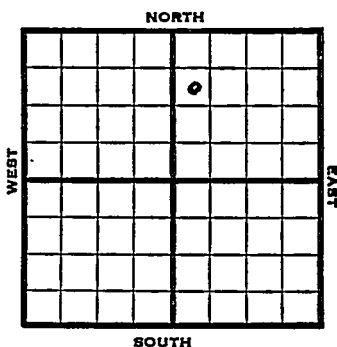

1953

Elev. 2048' REPORT

1/21

Spud 1-17-53

8" @ 206

Drlg. 1075'

1/29

Top 2981

DST 3122-52, 1/2 hrs., 8' M 915#

Heeb 3203, Tor 3225

DST 3210-38, 1 hr., 25' M 135#

Br li 3249, Lans 3259

DST 3252-3307, 1 hr., 30' M 32#

DST 3309-27 1/2 hrs., 5' M 0#

Drlg. 3475

2/4

Spud 1-17-53 D & A TD 3842'

8" @ 206 Top. 2976'

DST 3122-52 open 1/2 hr. rec 8' mud 915# Heeb 3203 Tor. 3225'

DST 3210-38 open 1 hr. rec 25' mud 135# Br. lime 3249' Lans. 3259'


DST 3252-3307 open 1 hr. rec 30' mud 32#

DST 3309-27-open 1/2 hr. rec 5' mud 0# Cong 3627 Viola 3698'

Simp. 3767' Arb. 3811'

DST 3815-35 open 3/4 hr. rec 2650' SW 1110# TD 3842' D & A

ABANDONED

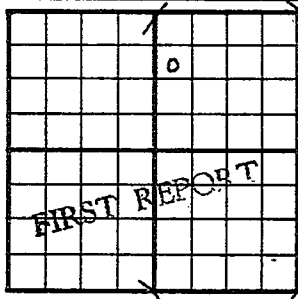County Osborne State KansasSec. 5 (Blk.) 9 (Sur.) 15W Map No.Operator Anderson-PrichardWell No. 1 Farm BeisnerElev. Location SEE MAP MAP990 Ft. From N Line NE330 Ft. From 1st Line Quarter1st. Report JAN 21 1953

Completion

Remarks


Glenn Peel - Contr.Spudding Date 1-17-53Drilg. Data Wildcat8" @ 206 d-lg. 1075

County Osborne State Kansas
 Sec. 5 (Blk.) 9 (Sur.) 15W Map No.

Operator Anderson-Prichard

Well No. 1 Farm Beisner

Elev. 2048 Location SW NW NE

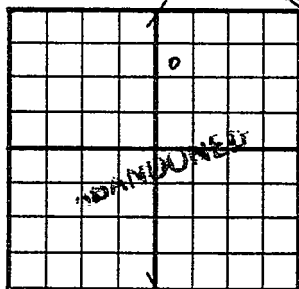

990 Ft. From N Line NE

330 Ft. From W Line Quarter

1st. Report

Completion FEB 4 1953

Remarks Wildcat

Glenn Peel - Contr.

Spudding Date 1-17-53

Drlg. Data D & A TD 3842

8" @ 206 Top. 2976 DST 3122-52

open $\frac{1}{2}$ hr. Rec. 8' mud 915# Heeb. 3203

Tor. 3225 DST 3210-38, open 1 hr.

Rec. 25' mud 135# Br. lime 3249

Lans. 3259 DST 3252-3307 open 1 hr.

Rec. 30' mud 32# DST 3309-27 open

$\frac{1}{2}$ hr. Rec. 5' mud 0# Cong. 3627

Viola 3698 Simp. 3767 Arb. 3811

DST 3815-35 open $\frac{3}{4}$ hr. Rec. 2650' sw

1110# TD 3842

D & A

J. G. McGEHEE