



KANSAS

Rooks

16W ✓

Sec. 5 Twp. 9 R. \_\_\_\_\_

Well No. #1 Dunlap Farm \_\_\_\_\_

Duke & Wood

Company

Wildcat (Duke & Wood, Cont.)

NORTH


330' Ft. from N. Line

\_\_\_\_\_ Ft. from S. Line

330' Ft. from E. Line

\_\_\_\_\_ Ft. from W. Line

NE/C

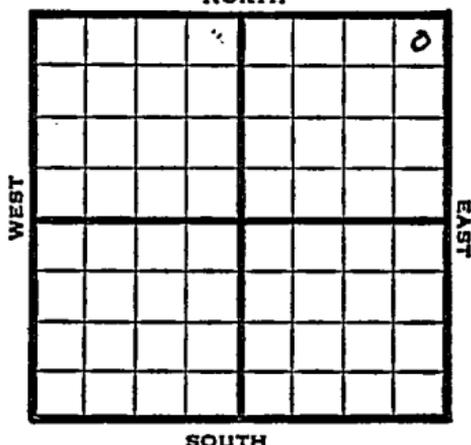

1949

Elev 1984' REPORT

6/22

8" @ 175'

Anhy. 1255'

Drlg. 1320'

Drlg 3247'

6/28

TD 3441'

Heebner 3063'

Lans. 3103'

BKC 3405'

Arb. 3425'

Aband. July 6, 1949

8/17

**ABANDONED**

*Let to Lewis  
8-19-49*

Map No. \_\_\_\_\_ Sec. 5 Twp. 9 R. 16W

Well No. 1 Dunlap

Duke & Wood Company

Duke & Wood Contractor

NE/c


FIRST REPORT

330 Ft. from N. Line

\_\_\_\_\_ Ft. from S. Line

330 Ft. from E. Line

\_\_\_\_\_ Ft. from W. Line

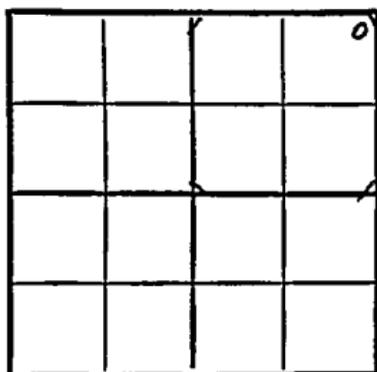

Rooks County

RECORD

Location \_\_\_\_\_

Cased \_\_\_\_\_ in., \_\_\_\_\_ ft.

Rig up \_\_\_\_\_

Sand \_\_\_\_\_

Drilling and Remarks:

Gas \_\_\_\_\_

8" @ 175

Oil \_\_\_\_\_

Anhy 1255

Total Depth \_\_\_\_\_

drlg. 1320

PRODUCTION

1st 24 hrs. Nat. \_\_\_\_\_

1st 24 hrs. after shot \_\_\_\_\_

Gas \_\_\_\_\_ Cu. Ft.

Dry Hole \_\_\_\_\_

Abandoned \_\_\_\_\_

Date

JUN 22 1949

19

S. J. LEWIS

Scout

Map No. K 64 Sec. 5 Twp. 9 R. 16W

Well No. 1 Dunlap

Duke & Wood Company

**ABANDONED**

Contractor

E. I. 1984

NE/C

**SECTION PLAT**

330 Ft. from N. Line

\_\_\_\_\_ Ft. from S. Line

330 Ft. from E. Line

\_\_\_\_\_ Ft. from W. Line

			△

Reeks County

Location \_\_\_\_\_

Rig up \_\_\_\_\_

Drilling and Remarks:

Heebner 3063

Lans. 3103

B KC 3405

Arb. 3425

Abandoned

July 6, 1949

**RECORD**

Cased \_\_\_\_\_ in., \_\_\_\_\_ ft.

Sand \_\_\_\_\_

Gas \_\_\_\_\_

Oil \_\_\_\_\_

Total Depth 2441

**PRODUCTION**

1st 24 hrs. Nat. \_\_\_\_\_

1st 24 hrs. after shot \_\_\_\_\_

Gas \_\_\_\_\_ Cu. Ft.

Dry Hole \_\_\_\_\_

Abandoned \_\_\_\_\_

Date

AUG 17 1949 19

S. J. LEWIS Scout