

Section 5 Township 9 Range 18W

Well No. #1 Holmes

Company Atlantic

Barry Pool

NORTH

0							

WEST

EAST

SOUTH

Sec. 5 Twp. 9 R. 18W

Well No. #1 Holmes Farm

Atlantic Company

Bary Pool


330' Ft. from N. Line

_____ Ft. from S. Line

_____ Ft. from E. Line

330' Ft. from W. Line

SW NW

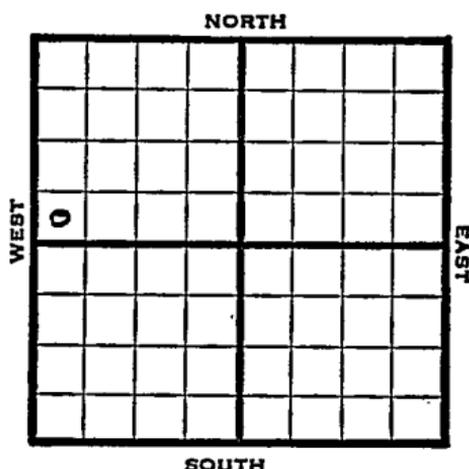

1948

Elev. 2077' REPORT

2/18

Location

2/25

10" @ 197'

Drlg. 1695'

3/3

Heebner 3211'

Lansing 3246'

Drlg. 3305'

3/10

Arbuckle 3495'

TD 3502'

5" @ 3498'

RUST

3/17

"

3/24

"

3/31

TD 3503'

1000 Acid

Swb 21 bbls. oil PH, 4 hrs.

4/7

"

4/14

TD 3505'

4/21

"

4/28

"

5/5

Arbuckle 3495'

5" @ 3498'

1000 Acid

Pump 346 oil & 5% W Pot.

Gr. 28°

TD 3505'

*3246
2077
1169*

*3495
2077
1418*

COMPLETED

Map No. _____ Sec. 5 Twp. 9 R. 18W

Well No. 1 Holmes

Atlantic Company

FIRST REPORT

Contractor _____

SW NW

SECTION PLAT

_____ Ft. from N. Line

330 Ft. from S. Line

_____ Ft. from E. Line

330 Ft. from W. Line

Rooks County

RECORD

Location X

Cased _____ in., _____ ft.

Rig up _____

Sand _____

Drilling and Remarks:

Gas _____

Oil _____

Total Depth _____

PRODUCTION

1st 24 hrs. Nat. _____

1st 24 hrs. after shot _____

Gas _____ Cu. Ft.

Dry Hole _____

Abandoned _____

Date

FEB 18 1948

19

S. J. LEWIS

Scout

