

Section 5 Township 9 Range 18W

Well No. #1 Holmes

Company B-H-P Oil

NORTH

	0						

WEST

EAST

SOUTH

Rooks

Sec. 5 Twp. 9 R. 18W

Well No. #1 Holmes Farm

B-H-P Oil Company

Contractor

East Barry Pool


Ft. from N. Line

990' Ft. from S. Line

Ft. from E. Line

990' Ft. from W. Line

NE SW NW

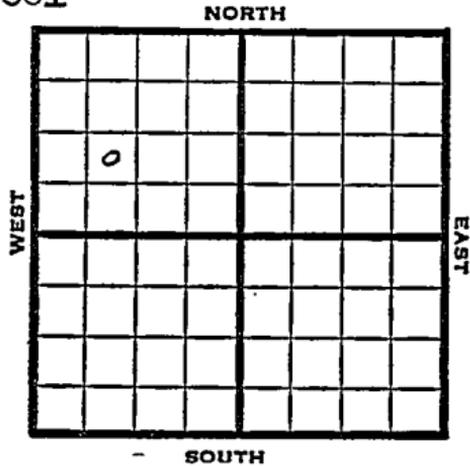

1950	Elev. 2068' REPORT
11/22	Cellar & Pits
1951	
4/11	Spud 11-23-50
	Oil well TD 3512'
	8-5/8" @ 200 Heeb 3200', Lans 3243'
	Cong 3477', Arb. 3485'
	TD 3494' 5" @ 3491' DD 3503'
	SSO DD 3512' B/1 1/2 BOPH
	Comp. 13 BOPD
	COMPLETED

3243
2068
1175

County _____ Rooks _____ State Kansas

Sec. 5 (Blk. (Twp.) 9 (Sur. Rge.) 18W Map No. _____

Operator B-H-P Oil

Well No. 1 Farm Holmes

Elev. 2068 Location NE SW NW

990 Ft. From S Line NW

990 Ft. From W Line Quarter

1st. Report _____

Completion APR 11 1951

Remarks East Berry Pool

Spudding Date 11-23-50

Drlg. Data Oil well TD 3512

8 5/8" @ 200 Heeb. 3200 Lans. 3243

Cong. 3477 Arb. 3485 TD 3494 5" @ 3491

DD 3503 SSO DD 3512 B/ 1 1/2 boph

Comp. 13 bopd

J. E. TYRA