

Section 5 Township 9 Range 18WWell No. 1 East HilgersCompany Gulf

Barry NORTH

WEST EAST

SOUTH

0

Rooks

KANSAS

Sec. 5 Twp. 9 R. 18-W

Well No. #1 East Hilgers Farm

Gulf Company

Barry Pool


990' Ft. from N. Line

Ft. from S. Line

Ft. from E. Line

330' Ft. from W. Line

SW NW SW

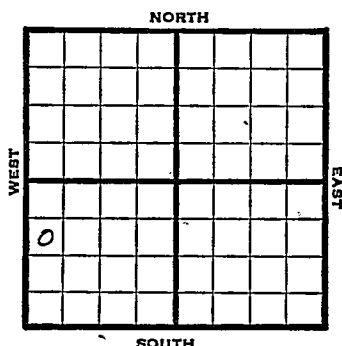

1947 Elev. 2075' REPORT

11/12 Loc.

11/19 RUR

11/25 "

12/6 18" @ 87'
8" @ 1468'
Drlg. 2000'

12/10 Lansing 3266'
Arbuckle 3554-84' TD
SG

12/17 Lansing 3266'
Arbuckle 3554'
TD 3584'

4
5 6 4
3 2 4
3 2

ABANDONED

Map No. _____ Sec. 5 Twp. 9 R. 18W

Well No. 1 East Hilgers

Gulf Company

FIRST REPORT Contractor

SW NW SW


SECTION PLAT

990 Ft. from N. Line

_____ Ft. from S. Line

_____ Ft. from E. Line

330 Ft. from W. Line

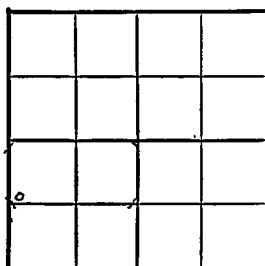

Rooks County

Location X

Rig up _____

Drilling and Remarks:

RECORD

Cased _____ in., _____ ft.

Sand _____

Gas _____

Oil _____

Total Depth _____

PRODUCTION

1st 24 hrs. Nat. _____

1st 24 hrs. after shot _____

Gas _____ Cu. Ft.

Dry Hole _____

Abandoned _____

Date

NOV 1 2 1947 19 S. J. LEWIS Scout

Kansas

Map No. 64 Sec. 5 Twp. 9 R. 18WWell No. 1 East HilgersGulf Company

ABANDONED

Contractor

SW NW SW

E/2075

SECTION PLAT

990 Ft. from N. Line Ft. from S. Line Ft. from E. Line330 Ft. from W. Line

o			

Rooks County

Location Rig up

Drilling and Remarks:

Lease 8266CU 82554

RECORD

Cased in., ft.Sand Gas Oil Total Depth 3084

PRODUCTION

1st 24 hrs. Nat. 1st 24 hrs. after shot Gas Cu. Ft.Dry Hole Abandoned

Date

DEC 17 1947

19

S. J. LEWIS

Scout