


Section 5 Township 9 Range 18-W

Well No. #2 Holmes

Company Atlantic
Barry Pool

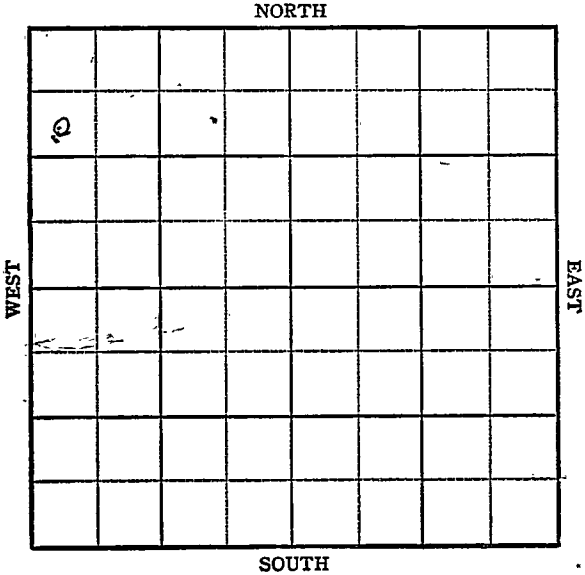

KANSAS

Rooks

Sec. 5 Twp. 9 R. 18W ✓

Well No. #2 Holmes Farm

Atlantic

Company

Barry Pool


990' Ft. from N. Line

 Ft. from S. Line

 Ft. from E. Line

330' Ft. from W. Line

SW NW NW

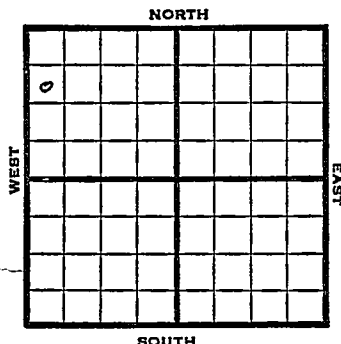

1948

Eli 2067'

REPORT

12/1

RUR

12/8

13 " @ 193'

Drlg 2305'

12/15

Lansing 3228'

Drlg 3365 SO

12/22

Arbuckle 3492-98'

TD 3498'

5" @ 3494'

12/29

"

1/5

"

1/12

"

1/19

TD 3498'

Arb 3492'

5" @ 3494'

Pump 220 Oil Pot

30° Gr.

Comp

COMPLETED

3297
2067
1228
2228
2067
1161

Map No. _____ Sec. 5 Twp. 9 R. 18WWell No. 2 HolmesAtlantic

Company

FIRST REPORT

Contractor

SW NW NW

SECTION PLAT

990 Ft. from N. Line

_____ Ft. from S. Line

_____ Ft. from E. Line

330 Ft. from W. Line

o			

Rooks County

Location _____

Rig up _____

Drilling and Remarks:

R U R

RECORD

Cased _____ in., _____ ft.

Sand _____

Gas _____

Oil _____

Total Depth _____

PRODUCTION

1st 24 hrs. Nat. _____

1st 24 hrs. after shot _____

Gas _____ Cu. Ft.

Dry Hole _____

Abandoned _____

Date

DEC 1 1948 19S. J. LEWIS

Scout

Map No. 64 Sec. 5 Twp. 9 R. 18W

Well No. 2 Holmes

Atlantic Company

COMPLETE

Contractor

SW NW NW


E12067
SECTION PLAT

990 Ft. from N. Line

 Ft. from S. Line

 Ft. from E. Line

330 Ft. from W. Line

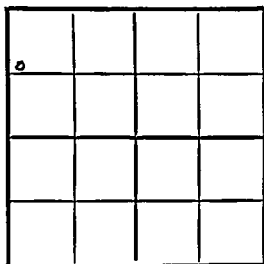

Rooks County

RECORD

Location

Cased in. ft.

Rig up

Sand

Drilling and Remarks:

Gas

Oil ✓

Total Depth 3498

Cr 3492

5" @ 3494

Pump 220 oil

PRODUCTION

1st 24 hrs. Nat.

1st 24 hrs. after shot

Gas Cu. Ft.

Dry Hole

Abandoned

20° SW

Date

JAN 19 1949

19

S. J. LEWIS

Scout