


Rooks

SECTION 5 TOWNSHIP 9 RANGE 18 W

WELL NO. #1 Meistrell

COMPANY C & G Drlg. & Oil Trading

NORTH

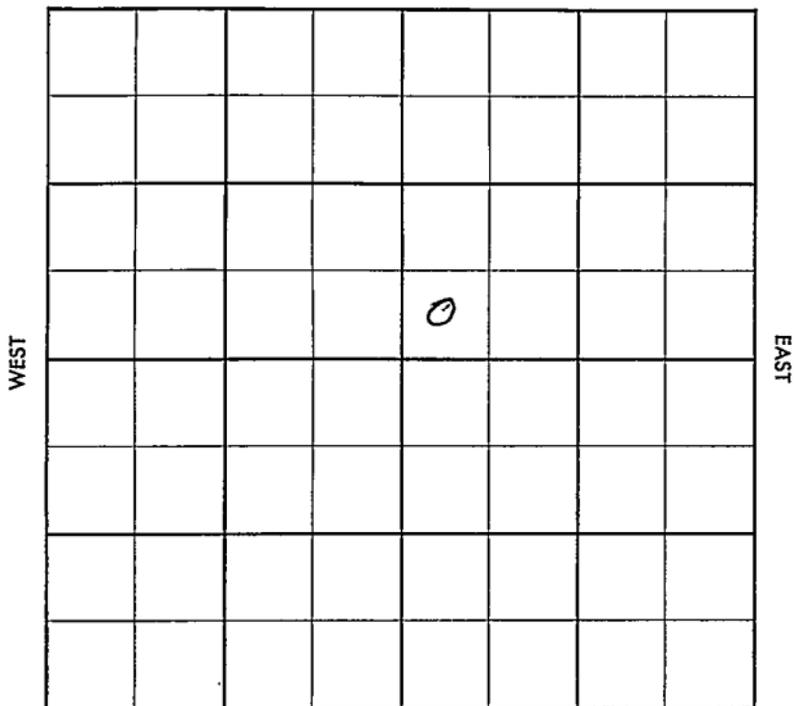

SOUTH

Rooks

KANSAS

SEC.	TWP.	R.
5	9	18W

WELL NO.

#1 Meistrell

FARM

COMPANY

C & G Drlg & Oil Trading

CONTRACTOR


E Barry

_____ Ft. from N. Line

_____ Ft. from S. Line

_____ Ft. from E. Line

_____ Ft. from W. Line

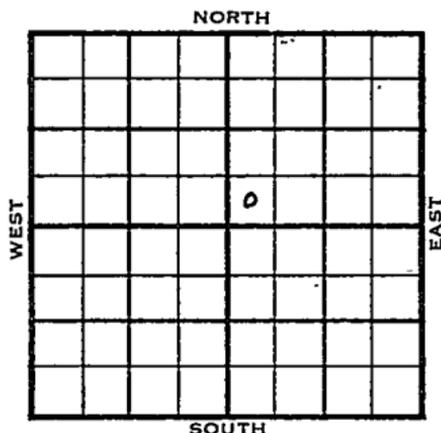

SW SW NE

Okmar - DHM

1955

ELEVATION

2053'

REPORT

11/16

Loc

11-30

Comm. 11-17-55

8 5/8" @ 191/125

DST 3330-40 op 1/2 hr. rec. 5' mud. O#

D & A

Anh. 1437

H. 3194

Tr. 3215

L. 3235

BKC 3441

Chert 3536

TD 3566'

ABANDONED

County Rooks Elev. _____
 Sec. 5 Twp. 9 Rge. 18W
 Company O & G Drilg. & Oil Trading
 Farm Name Meistrell No. 1

TOPS	DEPTH	LOG	DATUM	Loc. in Sec.
Anh.				SW SW NE
Tp.				
H.				
Tr.				
Dg.				
Bl.				
L.				Geol. _____
K.C.				Contr. _____
B.K.C.				
Ce.				
C.				
M.				Pool _____
M.				<u>E. Barry</u>
K.				
Mz.				
Ma.				
V.				
S.				
S.				
A.				
R.				
PE.				
G.				
T.D.				FIRST REPORT

Date Comm. Okmar - DFM
 Location NOV 16 1955

[Handwritten signature]

Co.

Lse.

No.

Sec.

T.

R.

County Rocks Elev. 2053
 Sec. 5 Twp. 9 Rge. 18W
 Company E & G Drlg. & Oil Trading
 Farm Name Meistrell No. 1

TOPS	DEPTH	LOG	DATUM	Loc. in Sec.
Anh.	<u>1437</u>			SW SW NE
TP.				
H.	<u>3194</u>		<u>1141</u>	
Tr.	<u>3215</u>		<u>1162</u>	
Dg.				
BL.				
L.	<u>3235</u>		<u>1182</u>	Geol.
K.C.				Contr.
B.K.G.	<u>3441</u>		<u>1388</u>	
Ce.				
C. <u>Chest</u>	<u>3536</u>		<u>1483</u>	
M.				Pool
M.				<u>E. Barry</u>
K.				
Mz.				
Ma.				
V.				
S.				
S.				
A.				
R.				
PE.				
G.				
TR.	<u>3566</u>			

ABANDONED

Date Comm. 11-17-55 NOV 30 1955

8 5/8" @ 191/125 DST 3330-40 open

1/2 hr. rec. 5' mud .0#

D & A