


Section 5 Township 9 Range 19W

Well No. #1 Oudrasek (A)

Company Walterd Drlg. Inc.

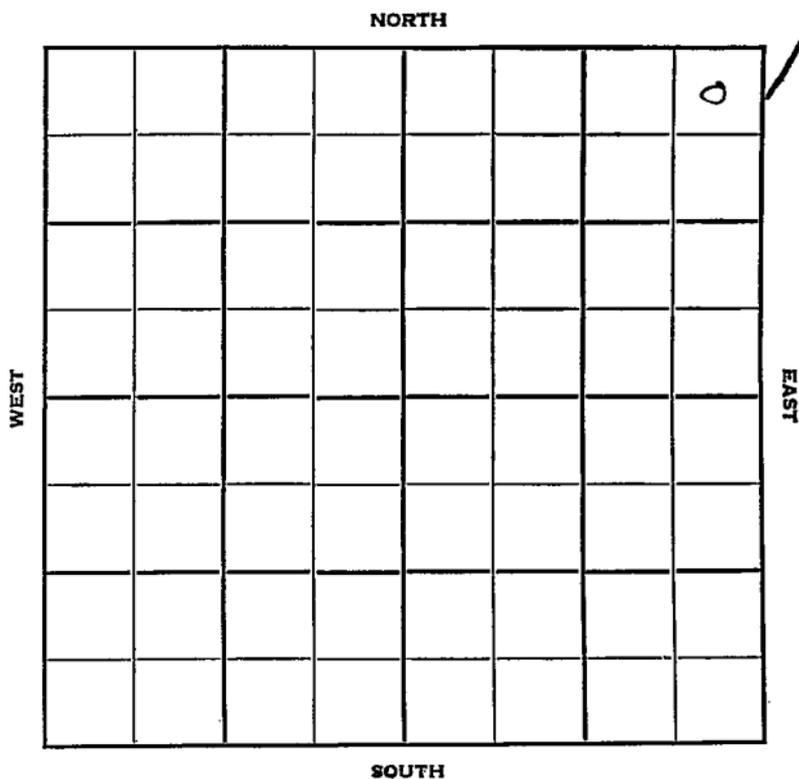

Sec. 5 Twp. 9 R. 19 W

Well No. # 1 Oudrasek (A) Farm

Walters Drlg. Inc. Company

Webster Contractor


330 Ft. from N. Line

\_\_\_\_\_ Ft. from S. Line

330 Ft. from E. Line

\_\_\_\_\_ Ft. from W. Line

NE NE NE

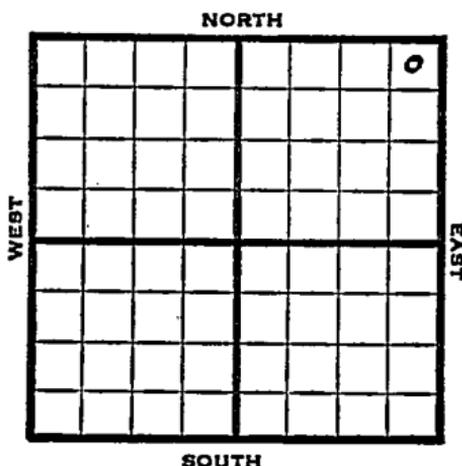

1952

Elev. 2040' REPORT

1/30

Spud 1-23-52  
8" @ 164'  
Anhy 1465'  
Drlg 2742'

2/6

Topeka 2994 Heeb. 3200  
Lans. 3240  
DST 3226-56, 1/2 hr. 1' mud, spots of  
oil, 460# BHP  
B KC 3453 Arb. 3480-84  
RTD 3467-84 45 mins., 5' mud  
5" @ 3482, RUCT

2/13

Spud 1-23-52  
D&A TD 3492'  
8" @ 164  
Anhy 1465 Top. 2994  
Heeb. 3200 Lans. 3240  
DST 3226-56 open 1/2 hr. rec. 6' mud  
spots of oil  
B KC 3453 Arb. 3480-84  
DST 3467-84 open 45 min. rec. 5' mud  
5" @ 3482 DP 3484 10 goph 2 hr.  
350 A S/ 1/2 boph 12 hr. 750 A  
3000 A S/ 3/4 boph 10 hr. DD 3486  
S/ 2 boph 6 hr. DD 3488 1/2 bfph  
3 hr. 50% wtr. DD 3492'  
S/ 1/2 bfph 10 hr.  
D&A

**ABANDONED**



County \_\_\_\_\_ Rooks \_\_\_\_\_ State Kansas  
 Sec. 5 (Blk. Twp.) 9 (Sur. Rge.) 19W Map No. \_\_\_\_\_  
 Operator Walters Drlg., Inc.  
 Well No. 1 Farm Oudrasek "A"  
 Elev. 2040 Location NE NE NE


330 Ft. From N Line NE

330 Ft. From E Line Quarter

1st. Report

Completion FEB 13 1952

Remarks Webster Pool

Spudding Date 1-23-52

Drlg. Data D &amp; A TD 3492

8" @ 164 Anhy 1465 Top. 2994

Heeb. 3200 Lans. 3240 DST 3226-56

open  $\frac{1}{2}$  hr. Rec. 6' mud spots of oil

B KC 3453 Arb. 3480-84 DST 3467-84

open 45 min. Rec. 5' mud 5" @ 3482

DP 3484 10 goph 2 hr. 350 A

S/  $\frac{1}{2}$  boph 12 hr. 750 A : 3000 AS/  $\frac{3}{4}$  boph 10 hr. DD 3486S/ 2 boph 6 hr. DD 3488  $\frac{1}{2}$  bfph 3 hr.50% water DD 3492 S/  $\frac{1}{2}$  bfph 10 hr.

D &amp; A

J. G. McGEHEE