


Section 5 Township 9 Range 19W

Well No. #1 Oudrasek

Company Jones-Shelburne & Farmer

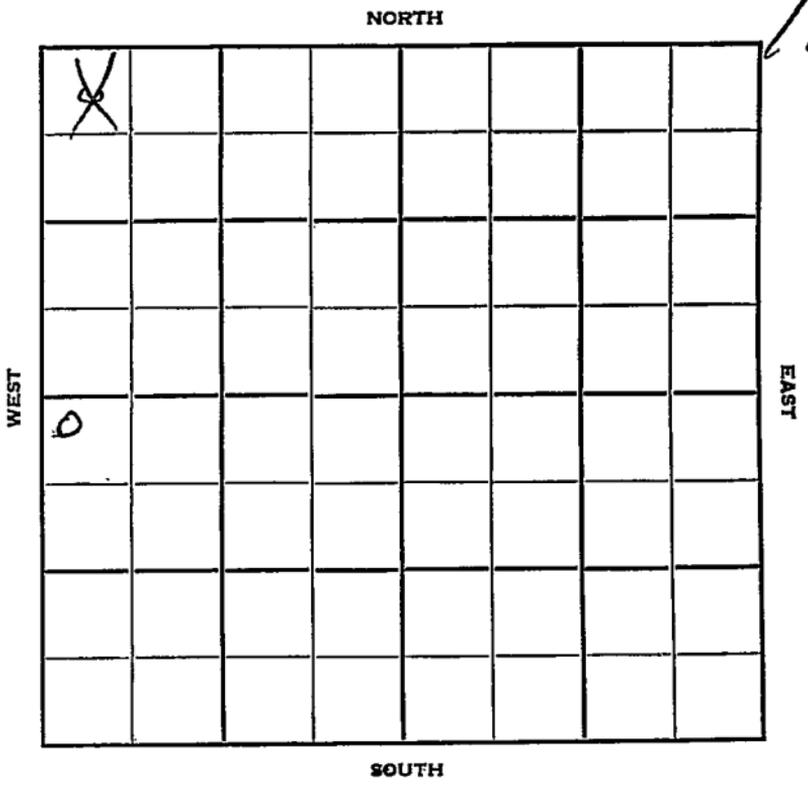

Rooks

KANSAS 19W

Sec. 5 Twp. 9 R. 19W

Well No. #1 Oudrasek Farm

Jones-Shelburne & Farmer Company

Contractor


330' Ft. from N. Line

_____ Ft. from S. Line

_____ Ft. from E. Line

330' Ft. from W. Line

NW NW ~~NW~~ ^{SW}

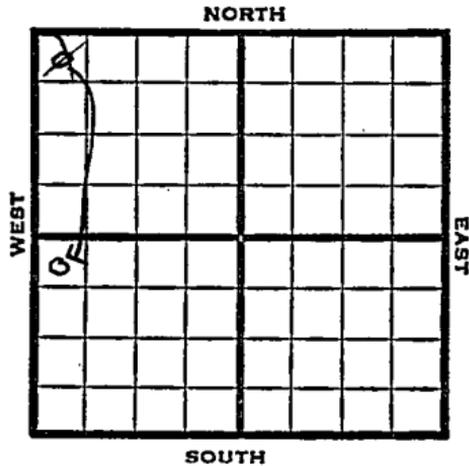

1952

Elev. 2072' REPORT

2/6 Location
 2/13 8" @ 160
 Drlg. 281'
 2/20 Spud 2-10-52
 D&A TD 3617
 8" @ 160
 Anhy 1535-70 Heeb. 3261
 Tor. 3284 Lans. 3306
 DST 3455-73 opn 1/2 hr. Rec. 10' mud
 Arb. 3602-17 TD D&A

ABANDONED

County Rooks State Kansas

Sec. 5 (Blk. Twp.) 9 (Sur. Rge.) 19W Map No.

Operator Jones-Shelburne & Farmer

Well No. 1 Farm Oudrasek

Elev. _____ Location NW NW NW

0					

330 Ft. From N Line NW

330 Ft. From N Line Quarter

Ist. Report FEB 6 1952

Completion _____

Remarks _____

Spudding Date _____

Drlg. Data _____

Location

J. G. MCGEHEE

Map No. _____ Sec. 5 Twp. 9 R. 19W

Well No. 1 Oudrasek

Jones, Shelborne & Farmer Company

CORRECTION

Contractor

NW NW SW

SECTION PLAT

330 Ft. from N. Line

_____ Ft. from S. Line

_____ Ft. from E. Line

330 Ft. from W. Line

o			

Rooks County

Location _____

Rig up _____

Drilling and Remarks:

Reported

NW NW NW

RECORD

Cased _____ in., _____ ft.

Sand _____

Gas _____

Oil _____

Total Depth _____

PRODUCTION

1st 24 hrs. Nat. _____

1st 24 hrs. after shot _____

Gas _____ Cu. Ft.

Dry Hole _____

Abandoned _____

Date

FEB 20 1952

19

J. G. MCGEHEE

Scout

