

Sec. 5 Twp. 9 R. _____

Well No. #1 Arpin Farm _____

Omega Oil Company _____

Peel Drlg. Contractor _____

Wildcat

_____ Ft. from N. Line

330 Ft. from S. Line


330 Ft. from E. Line

_____ Ft. from W. Line

SE SE SW

Stanolind Farmout

Skelly DHM

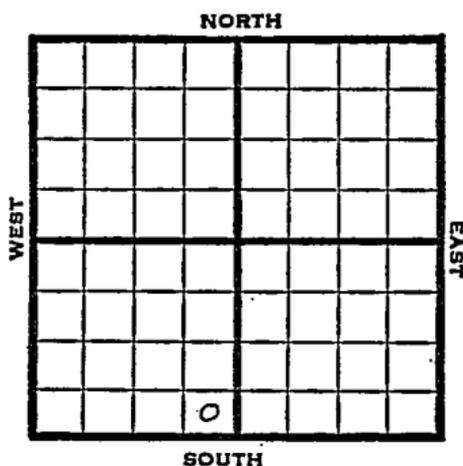

1950

Elev. 2155' REPORT

10/11

Spud 10-7-50

8" @ 187

drlg 1023

11/1

Spud 10-7-50

D&A TD 3846'

8" @ 187'

Anhy 1670-90 Heeb. 3360'

Lans. 3402

DST 3430-39 opn 1/2 hr

Rec. 5' mud

DST 3562-77 opn 45 min.

Rec/60' mud & wtr

BKC 3624 Cong. 3681

Ch Cong. 3769'

Arb. 3844-46

TD 3846' D&A

ABANDONED

