

Graham

FORM 51 25M 8-50 WESTERN

KANSAS

Section 5 Township 9 Range 21W

Well No. #1 Miller

Company Peel - Hardman

NORTH

WEST

EAST

SOUTH

6

Graham

KANSAS

Sec. 5 Twp. 9 R. 21W

Well No. #1 Miller Farm

Peel-Hardman Company

Wildcat Contractor


 Ft. from N. Line

330' Ft. from S. Line

330' Ft. from E. Line

 Ft. from W. Line

SE SE SW

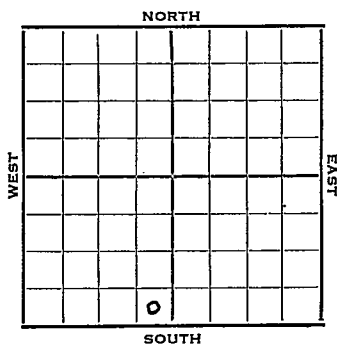

1951

Elev. 2298'

REPORT

11/28

Location

1952

1/16

Spud 12-27-51

D&A TD 3880'

8" @ 200

Heeb. 3478

Lans. 3518'

DST 3635-48 open $\frac{1}{2}$ hr. rec. 10' mud

DST 3647-90 open $\frac{1}{2}$ hr. rec. 10' mud

DST 3754-3800 open $\frac{1}{2}$ hr. rec. 15' mud


Cong. 3834 TD 3880'

D&A

ABANDONED

~~J. E. TYRA~~

County Graham State Kansas
 Sec. 5 (Blk.) 9 (Sur.) 21W Map No.
 Operator Peel - Hardman
 Well No. 1 Farm Miller
 Elev. 2298 Location SE SE SW

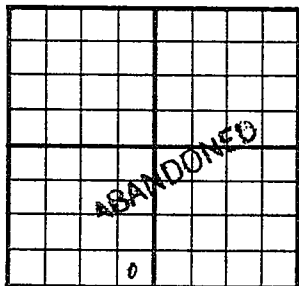

330 Ft. From S Line SW
330 Ft. From E Line Quarter
 Ist. Report
 Completion JAN 1 6 1952
 Remarks Wildcat

Spudding Date 12-27-51

Drlg. Data D & A TD 3880

8" @ 200 Heeb. 3478 Lans. 3518

DST 3635-48 ooen $\frac{1}{2}$ hr. Rec. 10' mud

DST 3647-90 open $\frac{1}{2}$ hr. Rec. 10' mud

DST 3754-3800 open $\frac{3}{4}$ hr. Rec. 15' mud

Cong. 3834 TD 3880

D & A

J. E. TYRA